WATER WELL RECORD Form WWC-5 KSA 82a-1212

| 1 LOCATION OF WATER WELL: County: Kiowa | Fraction: SW ¼ NW ¼ SE ¼ | Section Number: 16 | Township Number: T 28 S | Range Number: R 18 E/W |
|---|---|---|---|---|

Distance and direction from nearest town or city street address of well if located within city?
203 W. Kansas, Greensburg

2 WATER WELL OWNER:
RR#, St. Address, Box # : KWIK SHOP INC. 734 E. 4TH AVENUE
City, State, ZIP Code : HUTCHINSON, KS 67504

Board of Agriculture, Division of Water Resources Application Number:

3 LOCATE WELL'S LOCATION WITH AN "X" IN SECTION BOX:

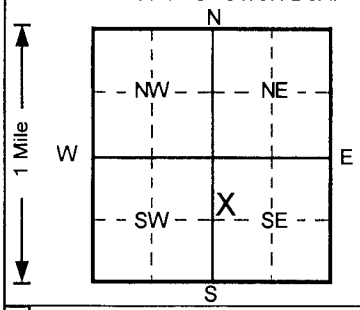


4 DEPTH OF COMPLETED WELL 25 ft. ELEVATION: 0
Depth(s) Groundwater Encountered 1. Dry ft. 2. ft. 3. ft.
WELL'S STATIC WATER LEVEL ft. below land surface measured on mo/day/yr
Pump test data: Well water was NA ft. after hours pumping gpm
Est. Yield NA gpm: Well water was ft. after hours pumping gpm
Bore Hole Diameter 8 in. to 25 ft., and in. to ft.
WELL WATER TO BE USED AS: 5 Public water supply 8 Air conditioning 11 Injection well
1 Domestic 3 Feedlot 6 Oil field water supply 9 Dewatering (12) Other (Specify below)
2 Irrigation 4 Industrial 7 Lawn and garden only 10 Monitoring well Soil vapor extractio
Was a chemical/bacteriological sample submitted to Department? Yes No ✓; If yes, mo/day/yr sample was submitted
Water Well Disinfected? Yes No ✓

5 TYPE OF BLANK CASING USED: 5 Wrought iron 8 Concrete tile CASING JOINTS: Glued Clamped
1 Steel 3 RMP (SR) 6 Asbestos-Cement 9 Other (specify below) Welded
(2) PVC 4 ABS 7 Fiberglass Threaded ✓
Blank casing diameter 4 in. to 10 ft., Dia in. to ft., Dia in. to ft.
Casing height above land surface 0 in., weight lbs./ft. Wall thickness or gauge No. Sch. 40
TYPE OF SCREEN OR PERFORATION MATERIAL (7) PVC 10 Asbestos-cement
1 Steel 3 Stainless steel 5 Fiberglass 8 RMP (SR) 11 Other (specify)
2 Brass 4 Galvanized steel 6 Concrete tile 9 ABS 12 None used (open hole)
SCREEN OR PERFORATION OPENINGS ARE: 5 Gauzed wrapped 8 Saw cut 11 None (open hole)
1 Continuous slot (3) Mill slot 6 Wire wrapped 9 Drilled holes
2 Louvered shutter 4 Key punched 7 Torch cut 10 Other (specify)
SCREEN-PERFORATED INTERVALS: From 10 ft. to 25 ft., From ft. to ft.
From ft. to ft., From ft. to ft.
GRAVEL PACK INTERVALS: From 8 ft. to 25 ft., From ft. to ft.
From ft. to ft., From ft. to ft.

6 GROUT MATERIAL: (1) Neat cement 2 Cement grout (3) Bentonite 4 Other
Grout Intervals: From 0 ft. to 0.7 ft., From 0.7 ft. to 8 ft., From ft. to ft.
What is the nearest source of possible contamination: 10 Livestock pens 14 Abandoned water well
1 Septic tank 4 Lateral lines 7 Pit privy (11) Fuel storage 15 Oil well/Gas well
2 Sewer lines 5 Cess pool 8 Sewage lagoon 12 Fertilizer storage 16 Other (specify below)
3 Watertight sewer lines 6 Seepage pit 9 Feedyard 13 Insecticide storage
Direction from well? West How many feet? 20

| FROM | TO | LITHOLOGIC LOG | FROM | TO | PLUGGING INTERVALS |
|---|---|---|---|---|---|
| 0 | 4.5 | Clay, fat, medium plasticity, Dark Brown | | | |
| 4.5 | 10 | Silt, clayey, medium plasticity, Tan | | | |
| 10 | 14.5 | Clay, fat, silty, medium plasticity, Brown | | | |
| 14.5 | 19 | Silt, clayey, medium plasticity, Tan | | | |
| 19 | 22 | Silt, w/fine sand, low plasticity, Tan | | | |
| 22 | 23.5 | Sand, fine grained, clayey, silty, | | | |
| 23.5 | 25 | Silt, clayey, medium plasticity, Tan | | | |
| | | | | | SVE2 , Flushmount |
| | | | | | Project Name: Terranext - Greensburg Kwik Shop #704 |
| | | | | | GeoCore # 1130 , # |

7 CONTRACTOR'S OR LANDOWNER'S CERTIFICATION: This water well was (1) constructed, (2) reconstructed, or (3) plugged under my jurisdiction and was completed on (mo/day/year) 2/19/2004 and this record is true to the best of my knowledge and belief. Kansas Water Well Contractor's License No. 527 This Water Well Record was completed on (mo/day/yr) 3/24/2004 under the business name of GeoCore, Inc. by (signature) Dale Kolp

INSTRUCTIONS: Use typewriter or ball point pen. *PLEASE PRESS FIRMLY* and *PRINT* clearly. Please fill in blanks, underline or circle the correct answers. Send top three copies to Kansas Department of Health and Environment, Bureau of Water, Topeka, Kansas 66620-0001. Telephone: 913-296-5545. Send one to WATER WELL OWNER and retain one for your records.

OFFICE USE ONLY T R E/W SEC. ¼ ¼ ¼