


WATER WELL RECORD Form WWC-5 KSA 82a-1212

1 LOCATION OF WATER WELL: Fraction Section Number Township Number Range Number
COUNTY: KIOWA SE 1/4 NE 1/4 SW 1/4 6 T 28 S R 18 W

Distance and direction from nearest town or city street address of well if located within city?
2 MILES WEST, 2.5 MILES NORTH OF GREENSBURG

2 WATER WELL OWNER: TGT PETROLEUM CORPORATION Board of Agriculture, Division of Water Resources
RR#, St. Address, Box #: PO BOX 75097
City, State, ZIP code: WICHITA, KS 67275-0097 Application Number: 20030271

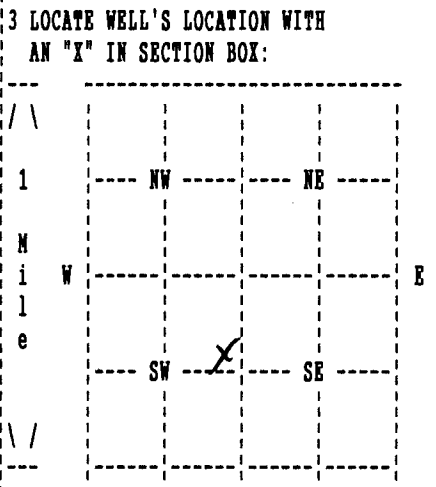

3 LOCATE WELL'S LOCATION WITH AN 'X' IN SECTION BOX:
4 DEPTH OF COMPLETED WELL 136 ELEVATION: 0
Depth(s) Groundwater Encountered 1. 0 ft. 2. 0 ft. 3. 0 ft.
WELL'S STATIC WATER LEVEL 82 ft. below land surface measured on mo/day/yr 11/24/03
Pump testdata: Well water was 0 ft. after 0 hours pumping 0 gpm
Estimated Yield 0 gpm: Well water was 0 ft. after 0 hours pumping 0 gpm
Bore Hole Diameter 8.75 in. to 136 ft., and in. to 0 ft.
WELL WATER TO BE USED AS: OIL FIELD
Was a chemical/bacteriological sample submitted to department? No;
If yes, mo/day/yr sample was submitted Water well disinfected? Yes

5 TYPE OF BLANK CASING USED: PVC CASING JOINTS: GLOUED
Blank casing diameter 5 in. to 116 ft., Dia in. to 0 ft., Dia in. to 0 ft.
Casing height above land surface 12 in., weight 0 lbs/ft. Wall thickness or gauge No. 26
TYPE OF SCREEN OR PERFORATION MATERIAL: PVC
SCREEN OR PERFORATION OPENINGS ARE: SAW CUT

SCREEN PERFORATED INTERVALS: From 116 ft. to 136 ft., From 0 ft. to 0 ft.
GRAVEL PACK INTERVALS: From 0 ft. to 0 ft., From 0 ft. to 0 ft.
From 24 ft. to 136 ft., From 0 ft. to 0 ft.
From 0 ft. to 0 ft., From 0 ft. to 0 ft.

6 GROUT MATERIAL BENTONITE
Grout Intervals: From 2 ft. to 24 ft., From 0 ft. to 0 ft., From 0 ft. to 0 ft.
What is the nearest source of possible contamination: OIL/GAS WELL
Direction from well? NORTH How many feet? 1200

Table with columns: FROM, TO, LITHOLOGIC LOG, FROM, TO, PLUGGING INTERVALS. Rows include: 0-21 SILT AND SAND, 21-43 TAN CLAY, 43-46 SAND, 46-62 TAN CLAY, 62-136 SAND AND GRAVEL.

7 CONTRACTOR'S OR LANDOWNER'S CERTIFICATION: This water well was Constructed under my jurisdiction and was completed on (mo/day/year) 11/24/03 and this record is true to the best of my knowledge and belief. Kansas Water Well Contractor's License No. 653A This Water Well Record was completed on (mo/day/yr) 12/29/03 under the business name of DAN HAYSE WATER WELL SVC. by (signature) Dan Hayse