WATER WELL RECORD Form WWC-5 KSA 82a-1212 ID No. _____

LOCATION OF WATER WELL:	Fraction	Section Number	Township Number	Range Number
ounty: Kiowa	SW ¼ SE ¼ SE ¼	16	T 29 S	R 18 E/W

istance and direction from nearest town or city street address of well if located within city?
Greensburg

WATER WELL OWNER: Rex Battler
R#, St. Address, Box # : 140 N Main
ity, State, ZIP Code : Greensburg, KS 67054

Board of Agriculture, Division of Water Resources
Application Number:

LOCATE WELL'S LOCATION WITH AN "X" IN SECTION BOX:

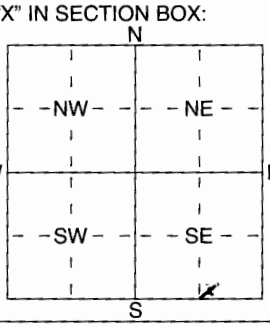

4 DEPTH OF COMPLETED WELL 105 ft. ELEVATION: .....

Depth(s) Groundwater Encountered 1 80 ft. 2 ..... ft. 3 ..... ft.

WELL'S STATIC WATER LEVEL 80 ft. below land surface measured on mo/day/yr .....

Pump test data: Well water was ..... ft. after ..... hours pumping ..... gpm

Est. Yield 20 gpm: Well water was ..... ft. after ..... hours pumping ..... gpm

WELL WATER TO BE USED AS: 1 Domestic 2 Irrigation 3 Feedlot 4 Industrial 5 Public water supply 6 Oil field water supply 7 Domestic (lawn & garden) 8 Air conditioning 9 Dewatering 10 Monitoring well 11 Injection well 12 Other (Specify below)

Was a chemical/bacteriological sample submitted to Department? Yes ..... No ..... ; If yes, mo/day/yrs sample was submitted

Water Well Disinfected? Yes No

TYPE OF BLANK CASING USED: 1 Steel 2 PVC 3 RMP (SR) 4 ABS 5 Wrought iron 6 Asbestos-Cement 7 Fiberglass 8 Concrete tile 9 Other (specify below)

CASING JOINTS: Glued X Clamped ..... Welded ..... Threaded .....

lank casing diameter 5 in. to 85 ft., Dia ..... in. to ..... ft., Dia ..... in. to ..... ft.

asing height above land surface 24 in., weight 5 OR 21 lbs./ft. Wall thickness or guage No. .....

YPE OF SCREEN OR PERFORATION MATERIAL: 1 Steel 2 Brass 3 Stainless Steel 4 Galvanized Steel 5 Fiberglass 6 Concrete tile 7 PVC 8 RMP (SR) 9 ABS 10 Asbestos-Cement 11 Other (Specify) ..... 12 None used (open hole)

CREEN OR PERFORATION OPENINGS ARE: 1 Continuous slot 2 Louvered shutter 3 Mill slot 4 Key punched 5 Guazed wrapped 6 Wire wrapped 7 Torch cut 8 Saw cut 9 Drilled holes 10 Other (specify) ..... 11 None (open hole)

CREEN-PERFORATED INTERVALS: From 85 ft. to 105 ft., From ..... ft. to ..... ft.
From ..... ft. to ..... ft., From ..... ft. to ..... ft.

GRAVEL PACK INTERVALS: From 26 ft. to 105 ft., From ..... ft. to ..... ft.
From ..... ft. to ..... ft., From ..... ft. to ..... ft.

GROUT MATERIAL: 1 Neat cement 2 Cement grout 3 Bentonite 4 Other .....

out Intervals: From 5 ft. to 26 ft., From ..... ft. to ..... ft., From ..... ft. to ..... ft.

hat is the nearest source of possible contamination:
1 Septic tank 2 Sewer lines 3 Watertight sewer lines 4 Lateral lines 5 Cess pool 6 Seepage pit 7 Pit privy 8 Sewage lagoon 9 Feedyard 10 Livestock pens 11 Fuel storage 12 Fertilizer storage 13 Insecticide storage 14 Abandoned water well 15 Oil well/Gas well 16 Other (specify below) .....

ection from well? How many feet?

ROM	TO	LITHOLOGIC LOG	FROM	TO	PLUGGING INTERVALS
0	57	Topsoil + Brown Sandy Clay			
7	79	Sand Medium to Coarse			
8	80	Brown Cl			
0	95	Sand Medium to Coarse Little Gravel			
5	105	Blue Clay			

NTRACTOR'S OR LANDOWNER'S CERTIFICATION: This water well was (1) constructed, (2) reconstructed, or (3) plugged under my jurisdiction and was ted on (mo/day/year) 7-1-05 and this record is true to the best of my knowledge and belief. Kansas Well Contractor's Licence No 677 This Water Well Record was completed on (mo/day/yr) 5-25-05
he business name of CLT Inc. by (signature) [signature]

RUCTIONS: Use typewriter or ball point pen. *PLEASE PRESS FIRMLY* and *PRINT* clearly. Please fill in blanks, underline or circle the correct answers. Send top three copies to Kansas Department of Health Environment, Bureau of Water, Geology Section, 1000 SW Jackson St., Suite 420, Topeka, Kansas 66612-1367. Telephone 785-296-5522. Send one to WATER WELL OWNER and retain one for your ds. Fee of $5.00 for each constructed well.