


1 LOCATION OF WATER WELL: County: DEOSHO Fraction: SW 1/4 SW 1/4 SW 1/4 Section Number: 4 Township Number: T 28 S Range Number: R 18 EW

Distance and direction from nearest town or city street address of well if located within city?
3/4 mile South of 35th Street of Chanute Ks.

2 WATER WELL OWNER: Allen Wickett
 RR#, St. Address, Box # 4680 S. Santa Fe. Board of Agriculture, Division of Water Resources
 City, State, ZIP Code Chanute Ks. 66720 Application Number:

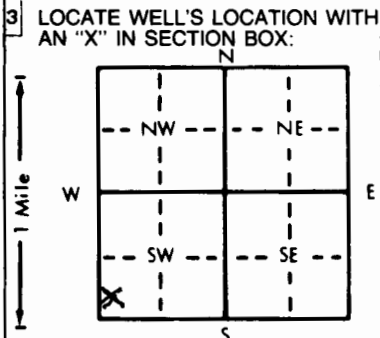

4 DEPTH OF COMPLETED WELL: 150 ft. ELEVATION:
 Depth(s) Groundwater Encountered 1. ft. 2. ft. 3. ft.
 WELL'S STATIC WATER LEVEL: 13 ft. below land surface measured on mo/day/yr 7-15-05
 Pump test data: Well water was ft. after hours pumping gpm
 Est. Yield 13 gpm: Well water was ft. after hours pumping gpm
 Bore Hole Diameter: 6 in. to 150 ft., and in. to ft.
 WELL WATER TO BE USED AS:
 5 Public water supply 8 Air conditioning 11 Injection well
 1 Domestic 3 Feedlot 6 Oil field water supply 9 Dewatering 12 Other (Specify below)
 2 Irrigation 4 Industrial 7 Lawn and garden only 10 Monitoring well TEST WELL
 Was a chemical/bacteriological sample submitted to Department? Yes..... No X.....; If yes, mo/day/yr sample was submitted
 Water Well Disinfected? Yes No

5 TYPE OF BLANK CASING USED:
 ① Steel 3 RMP (SR) 5 Wrought iron 8 Concrete tile CASING JOINTS: Glued Clamped
 2 PVC 4 ABS 6 Asbestos-Cement 9 Other (specify below) Welded
 7 Fiberglass Threaded
 Blank casing diameter 8 in. to 5 ft., Dia. in. to ft., Dia. in. to ft.
 Casing height above land surface 12 in., weight lbs./ft. Wall thickness or gauge No.
 TYPE OF SCREEN OR PERFORATION MATERIAL:
 1 Steel 3 Stainless steel 5 Fiberglass 7 PVC 10 Asbestos-cement
 2 Brass 4 Galvanized steel 6 Concrete tile 8 RMP (SR) 11 Other (specify)
 12 None used (open hole)
 SCREEN OR PERFORATION OPENINGS ARE:
 1 Continuous slot 3 Mill slot 5 Gauzed wrapped 8 Saw cut ① None (open hole)
 2 Louvered shutter 4 Key punched 6 Wire wrapped 9 Drilled holes
 7 Torch cut 10 Other (specify)
 SCREEN-PERFORATED INTERVALS: From ft. to ft., From ft. to ft.
 GRAVEL PACK INTERVALS: From ft. to ft., From ft. to ft.

6 GROUT MATERIAL: 1 Neat cement 2 Cement grout 3 Bentonite 4 Other
 Grout Intervals: From ft. to ft., From ft. to ft., From ft. to ft.
 What is the nearest source of possible contamination:
 1 Septic tank 4 Lateral lines 7 Pit privy 10 Livestock pens 14 Abandoned water well
 ② Sewer lines 5 Cess pool 8 Sewage lagoon 11 Fuel storage 15 Oil well/Gas well
 ③ Watertight sewer lines 6 Seepage pit 9 Feedyard 12 Fertilizer storage 16 Other (specify below)
 13 Insecticide storage
 Direction from well? How many feet?

FROM	TO	LITHOLOGIC LOG	FROM	TO	PLUGGING INTERVALS
0	2	Brown Clay			150-155 Show of dead
2	25	Brown Sandstone Hard			Oil
25	40	Gray Sandstone Hard			Plugged Back to 150
40	79	Gray Lime Shale firm			HOLE PLUG
79	81	Limestone			
81	88	Shale firm			
88	104	Quincy Shale			WELL MAKES 13 gal
104	127	Lime			Per. HOUR.
127	147	Quincy Shale firm			
147	155	Lime			Well pump to fill
					pond. ON TIMER.

7 CONTRACTOR'S OR LANDOWNER'S CERTIFICATION: This water well was (1) constructed, (2) reconstructed, or (3) plugged under my jurisdiction and was completed on (mo/day/year) 9-17-05 and this record is true to the best of my knowledge and belief. Kansas Water Well Contractor's License No. 623 This Water Well Record was completed on (mo/day/yr) 9-30-05 under the business name of Allen Chase Drilling by (signature) Allen Chase