


1 LOCATION OF WATER WELL: County: <b>Kiowa</b>	Fraction <b>SW ¼ NE ¼ SW ¼</b>	Section Number <b>16</b>	Township Number <b>T 28 S</b>	Range Number <b>R 18 E</b> <b>(W)</b>
---	-----------------------------------	-----------------------------	----------------------------------	--

Distance and direction from nearest town or city street address of well if located within city?  
**418 W. Kansas Ave., Greensburg**

2 WATER WELL OWNER: **Koehn 66**  
 RR#, St. Address, Box # : **13605 W. Maple, Suite 101**  
 City, State, ZIP Code : **Wichita, KS 67235**  
 Board of Agriculture, Division of Water Resources  
 Application Number:

3 LOCATE WELL'S LOCATION WITH AN "X" IN SECTION BOX:

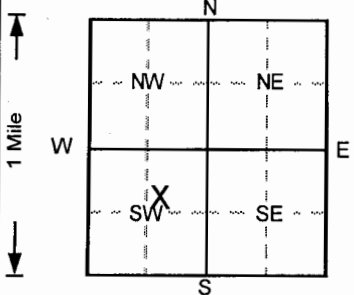

4 DEPTH OF COMPLETED WELL ..... **105** ..... ft. ELEVATION: .....

Depth(s) Groundwater Encountered 1. .... ft. 2. .... ft. 3. .... ft.

WELL'S STATIC WATER LEVEL ..... ft. below land surface measured on mo/day/yr .....

Pump test data: Well water was ..... **NA** ..... ft. after ..... hours pumping ..... gpm

Est. Yield ..... **NA** ..... gpm: Well water was ..... ft. after ..... hours pumping ..... gpm

Bore Hole Diameter ..... **8** ..... in. to ..... **105** ..... ft., and ..... in. to ..... ft.

WELL WATER TO BE USED AS: 5 Public water supply 8 Air conditioning 11 Injection well  
 1 Domestic 3 Feedlot 6 Oil field water supply 9 Dewatering **12 Other (Specify below)**  
 2 Irrigation 4 Industrial 7 Lawn and garden only 10 Monitoring well **Air sparge**

Was a chemical/bacteriological sample submitted to Department? Yes.....No  ..... If yes, mo/day/yr sample was submitted Water Well Disinfected? Yes No

5 TYPE OF BLANK CASING USED: 5 Wrought iron 8 Concrete tile CASING JOINTS: Glued ..... Clamped .....  
 1 Steel 3 RMP (SR) 6 Asbestos-Cement 9 Other (specify below) Welded .....  
**2 PVC** 4 ABS 7 Fiberglass Threaded

Blank casing diameter ..... **2** ..... in. to ..... **103** ..... ft., Dia ..... in. to ..... ft., Dia ..... in. to ..... ft.

Casing height above land surface ..... **0** ..... in., weight ..... lbs./ft. Wall thickness or gauge No. .... **Sch. 40** .....

TYPE OF SCREEN OR PERFORATION MATERIAL **7 PVC** 10 Asbestos-cement  
 1 Steel 3 Stainless steel 5 Fiberglass 8 RMP (SR) 11 Other (specify) .....

2 Brass 4 Galvanized steel 6 Concrete tile 9 ABS 12 None used (open hole)

SCREEN OR PERFORATION OPENINGS ARE: 5 Gauzed wrapped 8 Saw cut 11 None (open hole)  
 1 Continuous slot **3 Will slot** 6 Wire wrapped 9 Drilled holes  
 2 Louvered shutter 4 Key punched 7 Torch cut 10 Other (specify) .....

SCREEN-PERFORATED INTERVALS: From ..... **103** ..... ft. to ..... **105** ..... ft., From ..... ft. to ..... ft.  
 From ..... ft. to ..... ft., From ..... ft. to ..... ft.

GRAVEL PACK INTERVALS: From ..... **100** ..... ft. to ..... **105** ..... ft., From ..... ft. to ..... ft.  
 From ..... ft. to ..... ft., From ..... ft. to ..... ft.

6 GROUT MATERIAL: 1 Neat cement **2 Cement grout** **3 Bentonite** **4 Other Concrete** .....

Grout Intervals: From ..... **0** ..... ft. to ..... **3** ..... ft., From ..... **3** ..... ft. to ..... **90** ..... ft., From ..... **90** ..... ft. to ..... **100** ..... ft.

What is the nearest source of possible contamination: 10 Livestock pens 14 Abandoned water well  
 1 Septic tank 4 Lateral lines 7 Pit privy 11 Fuel storage 15 Oil well/Gas well  
 2 Sewer lines 5 Cess pool 8 Sewage lagoon 12 Fertilizer storage 16 Other (specify below)  
 3 Watertight sewer lines 6 Seepage pit 9 Feedyard 13 Insecticide storage

Direction from well? How many feet?

FROM	TO	LITHOLOGIC LOG	FROM	TO	PLUGGING INTERVALS
0	0.5	Concrete,	81	84	Sand (vf-m), silty, moist, sl. old gas odor, Brown
0.5	3	Silt, sl. clayey, moist, Reddish Brown	84	90	Sand (vf-c) w/f-c gravel, Brown
3	7	Silt, sl. sandy, moist, no odor, Brown	90	105	Sand (f-c) w/f-c gravel, rounded to subrounde
7	7.5	Sand (vf-c), moist, no odor, Brown			
7.5	12	Silt, tr. vf sand, moist, no odor, Brown			
12	20.5	Silt, clayey, sl. sandy, moist, no odor, Reddish			
20.5	25	Sand (vf-c), silty, moist, Reddish Brown			
25	34	Sand, as above, mod. moist, no odor,			
34	49	Sand (vf-f), clean, moist, no odor, Brown			
49	55	Sand (vf-f), occ. silt, Lt. Brown			
55	61	Sand (vf-m), moist, no odor, Brown			
61	65	Sand (vf), v. silty, clayey, moist, no odor, Gray			
65	69	Sand (vf-m), silty, moist, no odor, Brown mottl			AS3, Tag # 00372378, Flushmount
69	72	Sand (vf-c) w/tr. f gravel, silty, Brown			Project Name: GF - Koehn 66
72	81	Sand (vf-c) w/f-m gravel, subrounded, Brown			GeoCore # 1290, KDHE # U1 049 13273

7 CONTRACTOR'S OR LANDOWNER'S CERTIFICATION: This water well was **(1)** constructed, (2) reconstructed, or (3) plugged under my jurisdiction and was completed on (mo/day/year) ..... **8/1/2006** ..... and this record is true to the best of my knowledge and belief.  
 Kansas Water Well Contractor's License No. .... **527** ..... This Water Well Record was completed on (mo/day/yr) ..... **8/16/2006** .....  
 under the business name of **GeoCore, Inc.** by (signature) *Dale Bell*