


1 LOCATION OF WATER WELL: County: **Kiowa** Fraction: **SW 1/4 NE 1/4 SW 1/4** Section Number: **16** Township Number: **T 28 S** Range Number: **R 18 E/W**

Distance and direction from nearest town or city street address of well if located within city?
418 W. Kansas Ave., Greensburg

2 WATER WELL OWNER: **Koehn 66**
 RR#, St. Address, Box #: **13605 W. Maple, Suite 101**
 City, State, ZIP Code: **Wichita, KS 67235**
 Board of Agriculture, Division of Water Resources
 Application Number:

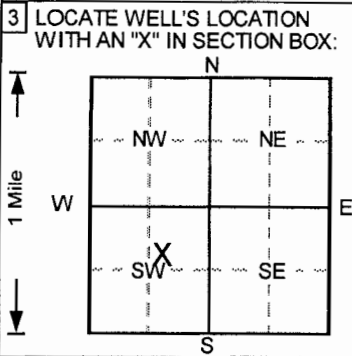

4 DEPTH OF COMPLETED WELL: **105** ft. ELEVATION: _____ ft.
 Depth(s) Groundwater Encountered 1. _____ ft. 2. _____ ft. 3. _____ ft.
 WELL'S STATIC WATER LEVEL _____ ft. below land surface measured on mo/day/yr _____
 Pump test data: Well water was **NA** ft. after _____ hours pumping _____ gpm
 Est. Yield **NA** gpm: Well water was _____ ft. after _____ hours pumping _____ gpm
 Bore Hole Diameter **8** in. to **105** ft., and _____ in. to _____ ft.
 WELL WATER TO BE USED AS: 5 Public water supply 8 Air conditioning 11 Injection well
 1 Domestic 3 Feedlot 6 Oil field water supply 9 Dewatering **12 Other (Specify below)**
 2 Irrigation 4 Industrial 7 Lawn and garden only 10 Monitoring well **Air sparge**
 Was a chemical/bacteriological sample submitted to Department? Yes _____ No ; If yes, mo/day/yr sample was submitted
 Water Well Disinfected? Yes _____ No

5 TYPE OF BLANK CASING USED:
 1 Steel 3 RMP (SR) 5 Wrought iron 8 Concrete tile CASING JOINTS: Glued _____ Clamped _____
2 PVC 4 ABS 6 Asbestos-Cement 9 Other (specify below) Welded _____
 7 Fiberglass _____ Threaded
 Blank casing diameter **2** in. to **103** ft., Dia _____ in. to _____ ft., Dia _____ in. to _____ ft.
 Casing height above land surface **0** in., weight _____ lbs./ft. Wall thickness or gauge No. **Sch. 40**

TYPE OF SCREEN OR PERFORATION MATERIAL
 1 Steel 3 Stainless steel 5 Fiberglass **7 PVC** 10 Asbestos-cement
 2 Brass 4 Galvanized steel 6 Concrete tile 8 RMP (SR) 11 Other (specify) _____
 9 ABS 12 None used (open hole)
 SCREEN OR PERFORATION OPENINGS ARE:
 1 Continuous slot **3 Mill slot** 5 Gauzed wrapped 8 Saw cut 11 None (open hole)
 2 Louvered shutter 4 Key punched 6 Wire wrapped 9 Drilled holes
 7 Torch cut 10 Other (specify) _____

SCREEN-PERFORATED INTERVALS: From **103** ft. to **105** ft., From _____ ft. to _____ ft.
 From _____ ft. to _____ ft., From _____ ft. to _____ ft.
 GRAVEL PACK INTERVALS: From **101** ft. to **105** ft., From _____ ft. to _____ ft.
 From _____ ft. to _____ ft., From _____ ft. to _____ ft.

6 GROUT MATERIAL: 1 Neat cement **2 Cement grout** **3 Bentonite** **4 Other Concrete** _____
 Grout Intervals: From **0** ft. to **3** ft., From **3** ft. to **91** ft., From **91** ft. to **101** ft.
 What is the nearest source of possible contamination:
 1 Septic tank 4 Lateral lines 7 Pit privy 10 Livestock pens 14 Abandoned water well
 2 Sewer lines 5 Cess pool 8 Sewage lagoon 11 Fuel storage 15 Oil well/Gas well
 3 Watertight sewer lines 6 Seepage pit 9 Feedyard 12 Fertilizer storage 16 Other (specify below)
 13 Insecticide storage _____
 Direction from well? _____ How many feet? _____

FROM	TO	LITHOLOGIC LOG	FROM	TO	PLUGGING INTERVALS
0	0.5	Concrete,	84	87	Sand (pred. as above) becoming v. moist,
0.5	3	Clay, v. silty, moist, no odor, Brown	87	89	Sand (vf-c) w/f-m gravel, v. clayey, Brown
3	9	Silt, clayey, moist, no odor, Brown	89	105	Sand (f-c) w/f-c gravel, subrounded to rounde
9	16	Silt, sandy (vf), sl. clayey, moist, no odor, Redd			
16	22	Silt, clayey, decr. sand, moist, no odor, Brown			
22	29	Sand, v. silty, sl. clayey, moist, no odor, Reddis			
29	33	Silt, sl. sandy, moist, no odor, Lt. Brown			
33	50	Sand (vf-f), silty, moist, no odor, Brown			
50	54	Sand (vf-f), Lt. Brown			
54	58	Silt, sl. sandy (vf), moist, tight, no odor, Brown			
58	60	Silt, sl. sandy (vf), moist, tight, Brown			
60	63	Sand (vf-m), moist, no odor, Brown			
63	71	Sand (vf-c), Brown			AS4, Tag # 00372385, Flushmount
71	74	Sand (vf-c) w/f gravel, silty, moist, no odor, Re			Project Name: GF - Koehn 66
74	84	Sand (vf-c) w/f-m gravel, subrounded, Brown			GeoCore # 1290, KDHE # U1 049 13273

7 CONTRACTOR'S OR LANDOWNER'S CERTIFICATION: This water well was **(1)** constructed, **(2)** reconstructed, or **(3)** plugged under my jurisdiction and was completed on (mo/day/year) **8/2/2006** and this record is true to the best of my knowledge and belief.
 Kansas Water Well Contractor's License No. **527** This Water Well Record was completed on (mo/day/yr) **8/23/06**
 under the business name of **GeoCore, Inc.** by (signature) *Don [unclear]*