


1 LOCATION OF WATER WELL: County: **Kiowa** Fraction: **SW 1/4 NE 1/4 SW 1/4** Section Number: **16** Township Number: **T 28 S** Range Number: **R 18 E/W**

Distance and direction from nearest town or city street address of well if located within city?
418 W. Kansas Ave., Greensburg

2 WATER WELL OWNER: **Koehn 66**
 RR#, St. Address, Box #: **13605 W. Maple, Suite 101** Board of Agriculture, Division of Water Resources
 City, State, ZIP Code: **Wichita, KS 67235** Application Number:

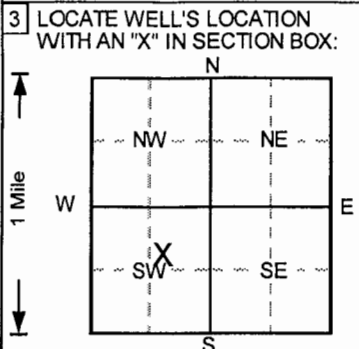

4 DEPTH OF COMPLETED WELL: **104** ft. ELEVATION:
 Depth(s) Groundwater Encountered 1. ft. 2. ft. 3. ft.
 WELL'S STATIC WATER LEVEL: ft. below land surface measured on mo/day/yr
 Pump test data: Well water was **NA** ft. after hours pumping gpm
 Est. Yield **NA** gpm: Well water was ft. after hours pumping gpm
 Bore Hole Diameter **8** in. to **104** ft., and in. to ft.
 WELL WATER TO BE USED AS:
 5 Public water supply 8 Air conditioning 11 Injection well
 1 Domestic 3 Feedlot 6 Oil field water supply 9 Dewatering **12** Other (Specify below)
 2 Irrigation 4 Industrial 7 Lawn and garden only 10 Monitoring well **Air sparge**
 Was a chemical/bacteriological sample submitted to Department? Yes.....No ..; If yes, mo/day/yr sample was submitted
 Water Well Disinfected? Yes No

5 TYPE OF BLANK CASING USED:
 1 Steel 3 RMP (SR) 5 Wrought iron 8 Concrete tile CASING JOINTS: Glued Clamped
2 PVC 4 ABS 6 Asbestos-Cement 9 Other (specify below) Welded
 7 Fiberglass Threaded.
 Blank casing diameter **2** in. to **102** ft., Dia. in. to ft., Dia. in. to ft.
 Casing height above land surface **0** in., weight lbs./ft. Wall thickness or gauge No. **Sch. 40**
 TYPE OF SCREEN OR PERFORATION MATERIAL:
 1 Steel 3 Stainless steel 5 Fiberglass **7** PVC 10 Asbestos-cement
 2 Brass 4 Galvanized steel 6 Concrete tile 8 RMP (SR) 11 Other (specify)
 12 None used (open hole)
 SCREEN OR PERFORATION OPENINGS ARE:
 1 Continuous slot **3** Mill slot 5 Gauzed wrapped 8 Saw cut 11 None (open hole)
 2 Louvered shutter 4 Key punched 6 Wire wrapped 9 Drilled holes
 7 Torch cut 10 Other (specify)
 SCREEN-PERFORATED INTERVALS: From **102** ft. to **104** ft., From ft. to ft.
 From ft. to ft., From ft. to ft.
 GRAVEL PACK INTERVALS: From **100** ft. to **104** ft., From ft. to ft.
 From ft. to ft., From ft. to ft.

6 GROUT MATERIAL: 1 Neat cement **2** Cement grout **3** Bentonite **4** Other **Concrete**
 Grout Intervals: From **0** ft. to **3** ft., From **3** ft. to **91** ft., From **91** ft. to **100** ft.
 What is the nearest source of possible contamination:
 1 Septic tank 4 Lateral lines 7 Pit privy 10 Livestock pens 14 Abandoned water well
 2 Sewer lines 5 Cess pool 8 Sewage lagoon 11 Fuel storage 15 Oil well/Gas well
 3 Watertight sewer lines 6 Seepage pit 9 Feedyard 12 Fertilizer storage 16 Other (specify below)
 13 Insecticide storage
 Direction from well? How many feet?

FROM	TO	LITHOLOGIC LOG	FROM	TO	PLUGGING INTERVALS
0	1	Clay, gravel, sand fill,	80	81	Sand, as above w/1" clay lense at 80.1' and 80.
1	4	Clay, v. silty, moist, plastic, no odor,	81	85	Sand (vf-c), subrounded, moist, no odor, Brown
4	8	Silt, clayey, moist, no odor, Brown	85	91	Sand (vf-c) w/f-c gravel, Brown
8	20	Silt, sl. clayey, moist, no odor, Reddish Brown	91	104	Sand (f-c) w/f-m gravel, tr. c gravel, Brown to
20	22	Silt, v. clayey, moist, no odor, Reddish Brown			
22	25	Sand (vf-m), v. silty, sl. clayey, moist, Reddish			
25	33	Sand (vf-f), v. silty w/silt stringers, moist, Red			
33	48	Sand (vf-m), silty, sl. moist, loose, no odor,			
48	55	Silt, sl. sandy (vf), moist, no odor, Lt. Brown			
55	58	Sand (vf-m), v. silty, moist, no odor, Lt. Brown			
58	60	Silt, sandy (vf), sl. clayey, moist, Lt. Grayish G			
60	63	Sand (vf), w sorted, moist, no odor, Lt. Brown			
63	68	Silt, sandy (vf), sl. clayey in part, moist, Lt. Br			AS5, Tag # 00372415, Flushmount
68	76	Sand (vf-c) w/f gravel, subrounded, silty, Bro			Project Name: GF - Koehn 66
76	80	Sand (vf-c) w/tr. f gravel, silty, moist, Brown t			GeoCore # 1290, KDHE # U1 049 13273

7 CONTRACTOR'S OR LANDOWNER'S CERTIFICATION: This water well was **(1)** constructed, (2) reconstructed, or (3) plugged under my jurisdiction and was completed on (mo/day/year) **8/7/2006** and this record is true to the best of my knowledge and belief.
 Kansas Water Well Contractor's License No. **527** This Water Well Record was completed on (mo/day/yr) **8/23/06**
 under the business name of **GeoCore, Inc.** by (signature) *Dale Relt*