


1 LOCATION OF WATER WELL: County: **Kiowa** Fraction: **SW 1/4 NE 1/4 SW 1/4** Section Number: **16** Township Number: **T 28 S** Range Number: **R 18 E/W**

Distance and direction from nearest town or city street address of well if located within city?  
**418 W. Kansas Ave., Greensburg**

2 WATER WELL OWNER: **Koehn 66**  
 RR#, St. Address, Box # : **13605 W. Maple, Suite 101** Board of Agriculture, Division of Water Resources  
 City, State, ZIP Code : **Wichita, KS 67235** Application Number:

3 LOCATE WELL'S LOCATION WITH AN "X" IN SECTION BOX:

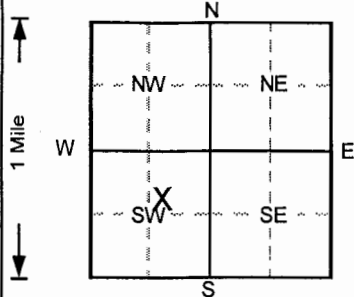

4 DEPTH OF COMPLETED WELL: **50** ft. ELEVATION: .....  
 Depth(s) Groundwater Encountered 1. .... ft. 2. .... ft. 3. .... ft.  
 WELL'S STATIC WATER LEVEL ..... ft. below land surface measured on mo/day/yr .....  
 Pump test data: Well water was **NA** ft. after ..... hours pumping ..... gpm  
 Est. Yield **NA** gpm: Well water was ..... ft. after ..... hours pumping ..... gpm  
 Bore Hole Diameter **.11** in. to **50** ft., and ..... in. to ..... ft.  
 WELL WATER TO BE USED AS: 5 Public water supply 8 Air conditioning 11 Injection well  
 1 Domestic 3 Feedlot 6 Oil field water supply 9 Dewatering **12 Other (Specify below)**  
 2 Irrigation 4 Industrial 7 Lawn and garden only 10 Monitoring well **Soil vapor extractio**  
 Was a chemical/bacteriological sample submitted to Department? Yes.....No  ; If yes, mo/day/yr sample was submitted  
 Water Well Disinfected? Yes No

5 TYPE OF BLANK CASING USED: 1 Steel 2 **PVC** 3 RMP (SR) 4 ABS 5 Wrought iron 6 Asbestos-Cement 7 Fiberglass 8 Concrete tile 9 Other (specify below) CASING JOINTS: Glued ..... Clamped ..... Welded ..... Threaded.   
 Blank casing diameter **4** in. to **40** ft., Dia ..... in. to ..... ft., Dia ..... in. to ..... ft.  
 Casing height above land surface **0** in., weight ..... lbs./ft. Wall thickness or gauge No. **Sch. 40**  
 TYPE OF SCREEN OR PERFORATION MATERIAL: 1 Steel 2 Brass 3 Stainless steel 4 Galvanized steel 5 Fiberglass 6 Concrete tile 7 **PVC** 8 RMP (SR) 9 ABS 10 Asbestos-cement 11 Other (specify) ..... 12 None used (open hole)  
 SCREEN OR PERFORATION OPENINGS ARE: 1 Continuous slot 2 Louvered shutter 3 **Mill slot** 4 Key punched 5 Gauzed wrapped 6 Wire wrapped 7 Torch cut 8 Saw cut 9 Drilled holes 10 Other (specify) ..... 11 None (open hole)  
 SCREEN-PERFORATED INTERVALS: From **40** ft. to **50** ft., From ..... ft. to ..... ft.  
 GRAVEL PACK INTERVALS: From **38** ft. to **50** ft., From ..... ft. to ..... ft.

6 GROUT MATERIAL: 1 Neat cement 2 Cement grout 3 **Bentonite** 4 **Other Concrete**  
 Grout intervals: From **0** ft. to **3** ft., From **3** ft. to **38** ft., From ..... ft. to ..... ft.  
 What is the nearest source of possible contamination: 1 Septic tank 2 Sewer lines 3 Watertight sewer lines 4 Lateral lines 5 Cess pool 6 Seepage pit 7 Pit privy 8 Sewage lagoon 9 Feedyard 10 Livestock pens 11 Fuel storage 12 Fertilizer storage 13 Insecticide storage 14 Abandoned water well 15 Oil well/Gas well 16 Other (specify below)  
 Direction from well? How many feet?

FROM	TO	LITHOLOGIC LOG	FROM	TO	PLUGGING INTERVALS
0	0.5	Concrete,			
0.5	1	Sand w/concrete debris,			
1	3	Clay, silty, moist, plastic, no odor, Dark Brow			
3	6	Silt, sl. clayey, moist, no odor, Dark Brown			
6	9	Clay, silty, moist, plastic, no odor, Dark Brow			
9	18	Silt, sandy (vf), sl. clayey, moist, no odor, Redd			
18	23	Sand (vf), v. silty, moist, no odor, Lt. Reddish			
23	25	Sand (vf-f), silty, moist, no odor, Lt. Reddish B			
25	29	Clay, v. silty, moist, plastic, no odor, Lt. Brow			
29	31	Sand (vf-f), silty, moist, no odor, Lt. Reddish B			
31	33	Silt, moist, no odor, Lt. Brown			
33	36	Silt, as above w/white calc. material,			
36	50	Sand (vf-f), sl. silty, sl odor to no odor, Lt. Red			
					SVE6, Tag # 00372453, Flushmount
					Project Name: GF - Koehn 66
					GeoCore # 1290, KDHE # U1 049 13273

7 CONTRACTOR'S OR LANDOWNER'S CERTIFICATION: This water well was **(1)** constructed, (2) reconstructed, or (3) plugged under my jurisdiction and was completed on (mo/day/year) **8/15/2006** and this record is true to the best of my knowledge and belief.  
 Kansas Water Well Contractor's License No. **527** This Water Well Record was completed on (mo/day/yr) **8/23/06**  
 under the business name of **GeoCore, Inc.** by (signature) *Don Bell*