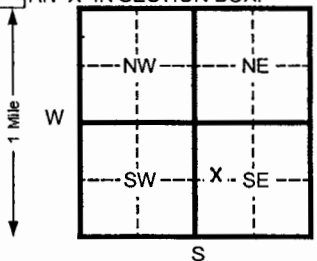


1 LOCATION OF WATER WELL: County: Kiowa	Fraction SW ¼ NW ¼ SE ¼	Section Number 16	Township Number T 28 S	Range Number R 18 W
---	-----------------------------------	-----------------------------	----------------------------------	-------------------------------

Distance and direction from nearest town or city street address of well if located within city?
203 West Kansas - Greensburg, KS

2 WATER WELL OWNER: **Kwik Shop #704**
 RR#, St. Address, Box # : **203 West Kansas** Board of Agriculture, Division of Water Resources
 City, State, ZIP Code : **Greensburg, KS** Application Number:

3 LOCATE WELL'S LOCATION WITH AN "X" IN SECTION BOX:


4 DEPTH OF COMPLETED WELL **98** ft. ELEVATION:
 Depth(s) Groundwater Encountered 1 _____ ft. 2 _____ ft. 3 _____ ft.
 WELL'S STATIC WATER LEVEL _____ ft. below land surface measured on mo/day/yr
 Pump test data: Well water was _____ ft. after _____ hours pumping _____ gpm
 Est. Yield _____ gpm: Well water was _____ ft. after _____ hours pumping _____ gpm
 Bore Hole Diameter **8.25** in. to **98** ft. and _____ in. to _____ ft.
 WELL WATER TO BE USED AS: 5 Public water supply 8 Air conditioning 11 Injection well
 1 Domestic 3 Feed lot 6 Oil field water supply 9 Dewatering 12 Other (Specify below)
 2 Irrigation 4 Industrial 7 Lawn and garden (domestic) **10 Monitoring well**
 Was a chemical/bacteriological sample submitted to Department? Yes _____ No **X** If yes, mo/day/yr sample was submitted _____
 Water Well Disinfected? Yes _____ No **X**

5 TYPE OF BLANK CASING USED:
 1 Steel **2 PVC** 3 RMP (SR) 4 ABS
 5 Wrought Iron 6 Asbestos-Cement 7 Fiberglass
 8 Concrete tile 9 Other (specify below)
 CASING JOINTS: Glued _____ Clamped _____
 Welded _____
 Threaded _____ **Flush**
 Blank casing diameter **2** in. to **96** ft., Dia _____ in. to _____ ft., Dia _____ in. to _____ ft.
 Casing height above land surface **Flush** in., weight **0.703** lbs./ft. Wall thickness or gauge No. **SCH. 40**

TYPE OF SCREEN OR PERFORATION MATERIAL:
 1 Steel 2 Brass 3 Stainless steel 4 Galvanized steel 5 Fiberglass 6 Concrete tile 7 **PVC** 8 RMP (SR) 9 ABS 10 Asbestos-cement 11 Other (specify) 12 None used (open hole)
 SCREEN OR PERFORATION OPENINGS ARE:
 1 Continuous slot 2 Louvered shutter 3 **Mill slot** 4 Key punched 5 Gauzed wrapped 6 Wire wrapped 7 Torch cut 8 Saw cut 9 Drilled holes 10 Other (specify) 11 None (open hole)
 SCREEN-PERFORATED INTERVALS: From **96** ft. to **98** ft. From _____ ft. to _____ ft.
 From _____ ft. to _____ ft. From _____ ft. to _____ ft.
 GRAVEL PACK INTERVALS: From **94** ft. to **98** ft. From _____ ft. to _____ ft.
 From _____ ft. to _____ ft. From _____ ft. to _____ ft.

6 GROUT MATERIAL: 1 Neat cement 2 **Cement grout** 3 **Bentonite** 4 Other _____
 Grout Intervals From **1** ft. to **70** ft. From **70** ft. to **94** ft. From _____ ft. to _____ ft.
 What is the nearest source of possible contamination:
 1 Septic tank 2 Sewer lines 3 Watertight sewer lines 4 Lateral lines 5 Cess pool 6 Seepage pit 7 Pit privy 8 Sewage lagoon 9 Feedyard 10 Livestock pens 11 Fuel storage 12 Fertilizer storage 13 Insecticide storage 14 Abandoned water well 15 Oil well/ Gas well 16 Other (specify below)
 Direction from well? _____ How many feet? _____

FROM	TO	CODE	LITHOLOGIC LOG	FROM	TO	PLUGGING INTERVALS
0	56.5		Silt, some clay, trace sand			
56.5	98		Sand, trace silt			

7 CONTRACTOR'S OR LANDOWNER'S CERTIFICATION: This water well was **(1) constructed**, (2) reconstructed, or (3) plugged under my jurisdiction and was completed on (mo/day/yr) **8/29/06** and this record is true to the best of my knowledge and belief. Kansas Water Well Contractor's License No. **531** This Water Well Record was completed on (mo/day/yr) **9/20/06** under the business name of **Geotechnical Services Inc.** by (signature) _____

INSTRUCTIONS: Please fill in blanks and circle the correct answers. Send three copies to Kansas Department of Health and Environment, Bureau of Water, 1000 S W Jackson St., Ste. 420, Topeka, Kansas 66612-1367. Telephone: 913-296-5545. Send one to WATER WELL OWNER and retain one for your records.

OFFICE USE ONLY

T

R

SEC