


1 LOCATION OF WATER WELL: County: Kiowa	Fraction SW ¼ NW ¼ SE ¼	Section Number 16	Township Number T 28 S	Range Number R 18 E/W
---	-----------------------------------	-----------------------------	----------------------------------	---------------------------------

Distance and direction from nearest town or city street address of well if located within city?
102 E. Kansas, Greensburg

2 WATER WELL OWNER: **Southern Plain Coop**
 RR#, St. Address, Box # : **P.O. Box 128**
 City, State, ZIP Code : **Lewis, KS 67552**
 Board of Agriculture, Division of Water Resources
 Application Number:

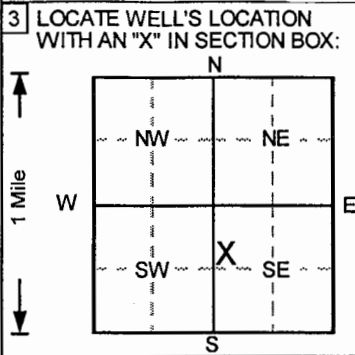

4 DEPTH OF COMPLETED WELL: **99.5** ft. ELEVATION: _____
 Depth(s) Groundwater Encountered 1. _____ ft. 2. _____ ft. 3. _____ ft.
 WELL'S STATIC WATER LEVEL _____ ft. below land surface measured on mo/day/yr _____
 Pump test data: Well water was **NA** ft. after _____ hours pumping _____ gpm
 Est. Yield **NA** gpm: Well water was _____ ft. after _____ hours pumping _____ gpm
 Bore Hole Diameter **8** in. to **99.5** ft., and _____ in. to _____ ft.
 WELL WATER TO BE USED AS:
 5 Public water supply 8 Air conditioning 11 Injection well
 1 Domestic 3 Feedlot 6 Oil field water supply 9 Dewatering **12 Other (Specify below)**
2 Irrigation 4 Industrial 7 Lawn and garden only 10 Monitoring well **Air sparge**
 Was a chemical/bacteriological sample submitted to Department? Yes.....No ; If yes, mo/day/yr sample was submitted
 Water Well Disinfected? Yes _____ No

5 TYPE OF BLANK CASING USED:
 1 Steel 3 RMP (SR) 5 Wrought iron 8 Concrete tile CASING JOINTS: Glued _____ Clamped _____
2 PVC 4 ABS 6 Asbestos-Cement 9 Other (specify below) Welded _____
 7 Fiberglass _____ Threaded
 Blank casing diameter **2** in. to **97.5** ft., Dia _____ in. to _____ ft., Dia _____ in. to _____ ft.
 Casing height above land surface **0** in., weight _____ lbs./ft. Wall thickness or gauge No. **Sch. 40**
 TYPE OF SCREEN OR PERFORATION MATERIAL **7 PVC** 10 Asbestos-cement
 1 Steel 3 Stainless steel 5 Fiberglass 8 RMP (SR) 11 Other (specify) _____
 2 Brass 4 Galvanized steel 6 Concrete tile 9 ABS 12 None used (open hole)
 SCREEN OR PERFORATION OPENINGS ARE:
 1 Continuous slot **3 Mill slot** 5 Gauzed wrapped 8 Saw cut 11 None (open hole)
 2 Louvered shutter 4 Key punched 6 Wire wrapped 9 Drilled holes
 7 Torch cut 10 Other (specify) _____
 SCREEN-PERFORATED INTERVALS: From **97.5** ft. to **99.5** ft., From _____ ft. to _____ ft.
 From _____ ft. to _____ ft., From _____ ft. to _____ ft.
 GRAVEL PACK INTERVALS: From **95.5** ft. to **99.5** ft., From _____ ft. to _____ ft.
 From _____ ft. to _____ ft., From _____ ft. to _____ ft.

6 GROUT MATERIAL: 1 Neat cement **2 Cement grout** **3 Bentonite** **4 Other Concrete**
 Grout Intervals: From **0** ft. to **3** ft., From **3** ft. to **84** ft., From **84** ft. to **95.5** ft.
 What is the nearest source of possible contamination:
 1 Septic tank 4 Lateral lines 7 Pit privy 10 Livestock pens 14 Abandoned water well
 2 Sewer lines 5 Cess pool 8 Sewage lagoon 11 Fuel storage 15 Oil well/Gas well
 3 Watertight sewer lines 6 Seepage pit 9 Feedyard 12 Fertilizer storage 16 Other (specify below)
 13 Insecticide storage
 Direction from well? _____ How many feet? _____

FROM	TO	LITHOLOGIC LOG	FROM	TO	PLUGGING INTERVALS
0	1	Clay, sand, gravel, cobbles (fill),	75	85	Sand (f-c) w/f-m gravel, subrounded, Brown
1	4	Clay, v. silty, moist, plastic, no odor, Brown	85	93	Sand (f-c) w/f-m gravel, subrounded, Brown
4	11	Sand (vf-f), v. silty, sl. moist, no odor, Reddish	93	99.5	Sand (vf-c) w/f gravel, v. silty, Brown
11	16	Clay, v. sandy, silty, moist, no odor,			
16	25	Clay, decreasing sand, moist,			
25	28	Silt, sl. sandy, sl. moist, no odor, Yellowish Bro			
28	30	Sand (vf-f), sl. silty, sl. moist, no odor, Yellowis			
30	38	Silt, sandy (vf), occ. clayey stringers, Yellowis			
38	39.5	Sand (vf-f), silty, sl. moist, no odor, Yellowish			
39.5	45	Clay, v. silty, sandy (vf), sl. moist, Yellowish B			
45	53	Clay, silty, sandy, plastic, no odor, Yellowish			
53	59	Clay, silty, sandy, becoming stiff, Yellowish Br			
59	61	Silt, sandy (vf), sl. moist, no odor, Yellowish B			AS13, Tag # 00373463, Flushmount
61	68	Sand (vf-m, tr. f gravel, subrounded, Brown			Project Name: GF - Farmer's Grain Supply
68	75	Sand (f-c) w/f gravel, subrounded, Brown			GeoCore # 1322, KDHE # U1 049 00461

7 CONTRACTOR'S OR LANDOWNER'S CERTIFICATION: This water well was **(1)** constructed, (2) reconstructed, or (3) plugged under my jurisdiction and was completed on (mo/day/year) **11/29/2006** and this record is true to the best of my knowledge and belief.
 Kansas Water Well Contractor's License No. **527** This Water Well Record was completed on (mo/day/yr) **12/27/2006**
 under the business name of **GeoCore, Inc.** by (signature) *Dale Rohl*

INSTRUCTIONS: Use typewriter or ball point pen. PLEASE PRESS FIRMLY and PRINT clearly. Please fill in blanks, underline or circle the correct answers. Send top three copies to Kansas Department of Health and Environment, Bureau of Water, Topeka, Kansas 66620-0001. Telephone: 913-296-5545. Send one to WATER WELL OWNER and retain one for your records.

OFFICE USE ONLY
T
R
EW
SEC.