

CORRECTION(S) TO WATER WELL RECORD (WWC-5)

(to rectify lacking or incorrect information)

County: Kiowa

Location listed as:

Section-Township-Range: 21-2-18W

Fraction ($\frac{1}{4}$ $\frac{1}{4}$ $\frac{1}{4}$): SE SE SE

Location changed to:

21-285-18W

SE SE SE

Other changes: Initial statements: _____

Changed to: _____

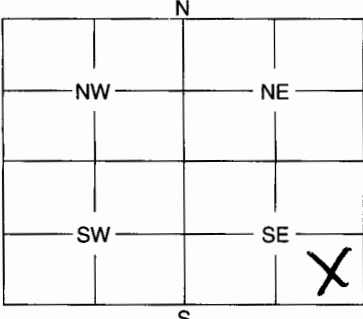
Comments: _____

verification method: Written & legal descriptions, other records for same owner in same section, and mapping tool on KGS website. initials: DRJ date: 2/13/2007

1 LOCATION OF WATER WELL: Fraction Section Number Township Number Range Number
 County: King SE 1/4 SE 3/4 SE 1/4 21 2 18 EW

Distance and direction from nearest town or city street address of well if located within city?
SE of Greensburg

2 WATER WELL OWNER: Pat Greenleaf
 RR #, St. Address, Box #: Rt. 1 Board of Agriculture, Division of Water Resources
 City, State, ZIP Code: Greensburg KS 67039 Application Number: _____

3 MARK WELL'S LOCATION WITH AN "X" IN SECTION BOX:


4 DEPTH OF WELL 120 ft. 121 ft.
 WELL'S STATIC WATER LEVEL 117 ft.
 WELL WAS USED AS:
 1 Domestic 5 Public Water Supply 9 Dewatering
 2 Irrigation 6 Oil Field Water Supply 10 Monitoring Well
 3 Feedlot 7 Domestic (Lawn & Garden) 11 Injection Well
 4 Industrial 8 Air Conditioning 12 Other
 Was a chemical / bacteriological sample submitted to Department? Yes No
 If yes, mo/day/yr sample was submitted
 Water Well Disinfected: Yes No

5 TYPE OF BLANK CASING USED:
 1 Steel 3 RMP (SR) 5 Wrought 7 Fiberglass 9 Other (Specify below)
 2 PVC 4 ABS 6 Asbestos-Cement 8 Concrete Tile
 Blank casing diameter 5 in. Was casing pulled? Yes No If yes, how much
 Casing height above or below land surface 48 in.

6 GROUT PLUG MATERIAL: 1 Neat cement 2 Cement grout 3 Bentonite 4 Other
 Grout Plug Intervals: From 11 ft. to 4 ft., From ft. to ft., From to ft.
 What is the nearest source of possible contamination:
 1 Septic tank 6 Seepage pit 11 Fuel storage 16 Other (specify below)
 2 Sewer lines 7 Pit privy 12 Fertilizer storage
 3 Watertight sewer lines 8 Sewage lagoon 13 Insecticide storage
 4 Lateral lines 9 Feedyard 14 Abandoned water well
 5 Cess pool 10 Livestock pens 15 Oil well/Gas well
 Direction from well? South How many feet? 300

FROM	TO	PLUGGING MATERIALS
<u>12</u>	<u>4</u>	<u>Bentonite</u>
<u>4</u>	<u>0</u>	<u>Black Clay</u>

7 CONTRACTOR'S OF LANDOWNER'S CERTIFICATION: This water well was plugged under my jurisdiction and was completed on (mo/day/year) 1-4-07 and this record is true to the best of my knowledge and belief. Kansas Water Well Contractor's License No. 673 This Water Well Record was completed on (mo/day/year) 1-22-07 under the business name of Cross Water Well by (signature) [Signature]

INSTRUCTIONS: Use typewriter or ball point pen. Please press firmly and print clearly. Please fill in blanks, underline or circle the correct answers. Send top three copies to Kansas Department of Health and Environment, Bureau of Water, Geology Section, 1000 SW Jackson St., Ste. 420, Topeka, Kansas 66612-1367. Telephone: 785/296-5522. Send one to Water Well Owner and retain one for your records.