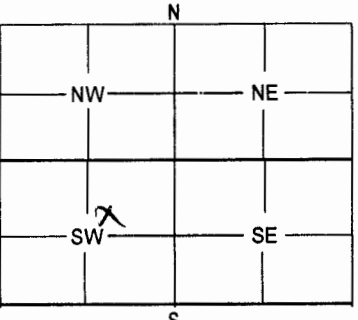


1	LOCATION OF WATER WELL:	Fraction	Section Number	Township Number	Range Number
	County: Kiowa	SW 1/4 NE 1/4 SW 1/4	16	28	18 E/W

Distance and direction from nearest town or city street address of well if located within city?

W. Kansas Ave. and Grove St., Greensburg, KS

2	WATER WELL OWNER: Coastal Mart Inc. #2509	Board of Agriculture, Division of Water Resources
	RR #, St. Address, Box # 2 N. Nevada	Application Number:
	City, State, ZIP Code Colorado Springs, CO 80903	

3	MARK WELL'S LOCATION WITH AN "X" IN SECTION BOX:	4	DEPTH OF WELL 98.5 ft.
			WELL'S STATIC WATER LEVEL 90.09 ft.
			WELL WAS USED AS:
			1 Domestic                      5 Public Water Supply                      9 Dewatering 2 Irrigation                      6 Oil Field Water Supply                      10 Monitoring Well 3 Feedlot                          7 Domestic (Lawn & Garden)                      11 Injection Well 4 Industrial                      8 Air Conditioning                          12 Other
			Was a chemical / bacteriological sample submitted to Department? Yes _____ No <u>X</u> if yes, mo/day/yr sample was submitted _____
			Water Well Disinfected: Yes _____ No <u>X</u>

5	TYPE OF BLANK CASING USED:
	1 Steel                      3 RMP (SR)                      5 Wrought                      7 Fiberglass                      9 Other (Specify below) 2 PVC                      4 ABS                          6 Asbestos-Cement                      8 Concrete Tile
	Blank casing diameter 2 in.                      Was casing pulled? Yes <u>X</u> No _____ If yes, how much 4'
	Casing height above or below land surface 4' below _____ in.

6	GROUT PLUG MATERIAL:	1 Neat cement	2 Cement grout	3 Bentonite	4 Other Cement
	Grout Plug Intervals:	From 98.5 ft. to 3 ft.	From 3 ft. to 0 ft.	From _____ ft. to _____ ft.	From _____ ft. to _____ ft.
	What is the nearest source of possible contamination:				
	1 Septic tank                      6 Seepage pit                      11 Fuel storage                      16 Other (specify below) 2 Sewer lines                      7 Pit privy                          12 Fertilizer storage 3 Watertight sewer lines                      8 Sewage lagoon                      13 Insecticide storage 4 Lateral lines                      9 Feedyard                          14 Abandoned water well 5 Cess pool                          10 Livestock pens                      15 Oil well/Gas well				
	Direction from well? 999		How many feet? 999		

FROM	TO	PLUGGING MATERIALS
98.5	3	3/8 Bentonite chips
3	0	Cement
		VOBWD-2

7	CONTRACTOR'S OF LANDOWNER'S CERTIFICATION: This water well was plugged under my jurisdiction and was completed on (mo/day/year) 4-11-07 and this record is true to the best of my knowledge and belief. Kansas Water Well Contractor's License No. 665 This Water Well Record was completed on (mo/day/year) 4-27-07 under the business name of Pratt Well Environmental
	by (signature) <i>Steven E. Pratt</i>

INSTRUCTIONS: Use typewriter or ball point pen. Please press firmly and print clearly. Please fill in blanks, underline or circle the correct answers. Send top three copies to Kansas Department of Health and Environment, Bureau of Water, Geology Section, 1 000 SW Jackson St., Ste. 420, Topeka, Kansas 66612-1367. Telephone: 785/296-5522. Send one to Water Well Owner and retain one for your records.