


1 LOCATION OF WATER WELL: County: Kiowa	Fraction SW <sup>1/4</sup> NE <sup>1/4</sup> SW <sup>1/4</sup>	Section 16	Number	Township 28	Number	Range 18	Number <b>EW</b>
--	---	---------------	--------	----------------	--------	-------------	---------------------

Distance and direction from nearest town or city street address of well if located within city?  
 W. Kansas Ave. and Grove St., Greensburg, KS

2 WATER WELL OWNER: Coastal Mart Inc. #2509  
 RR #, St. Address, Box # 2 N. Nevada Board of Agriculture, Division of Water Resources  
 City, State, ZIP Code Colorado Springs, CO 80903 Application Number:

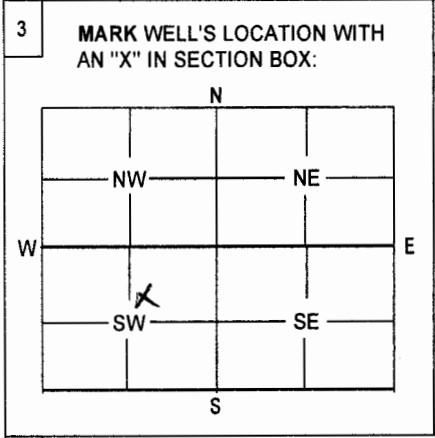

4 DEPTH OF WELL 96.85 ft.  
 WELL'S STATIC WATER LEVEL 88.45 ft.  
 WELL WAS USED AS:  
 1 Domestic 2 Irrigation 3 Feedlot 4 Industrial 5 Public Water Supply 6 Oil Field Water Supply 7 Domestic (Lawn & Garden) 8 Air Conditioning 9 Dewatering 10 Monitoring Well 11 Injection Well 12 Other

Was a chemical / bacteriological sample submitted to Department? Yes No **X**  
 if yes, mo/day/yr sample was submitted

Water Well Disinfected: Yes No **X**

5 TYPE OF BLANK CASING USED:  
 1 Steel 2 PVC 3 RMP (SR) 4 ABS 5 Wrought 6 Asbestos-Cement 7 Fiberglass 8 Concrete Tile 9 Other (Specify below)

Blank casing diameter 2 in. Was casing pulled? Yes **X** No If yes, how much 4' below  
 Casing height above or below land surface 4' below in.

6 GROUT PLUG MATERIAL: 1 Neat cement 2 Cement grout 3 Bentonite 4 Other Topsoil  
 Grout Plug Intervals: From 96.85 ft. to 3 ft., From 3 ft. to 0 ft., From to ft.

What is the nearest source of possible contamination:  
 1 Septic tank 2 Sewer lines 3 Watertight sewer lines 4 Lateral lines 5 Cess pool 6 Seepage pit 7 Pit privy 8 Sewage lagoon 9 Feedyard 10 Livestock pens 11 Fuel storage 12 Fertilizer storage 13 Insecticide storage 14 Abandoned water well 15 Oil well/Gas well 16 Other (specify below)

Direction from well? 999 How many feet? 999

FROM	TO	PLUGGING MATERIALS
96.85	3	3/8 Bentonite chips
3	0	Topsoil
		MW-9

7 CONTRACTOR'S OF LANDOWNER'S CERTIFICATION: This water well was plugged under my jurisdiction and was completed on (mo/day/year) 4-11-07 and this record is true to the best of my knowledge and belief. Kansas Water Well Contractor's License No. 665 This Water Well Record was completed on (mo/day/year) 4-27-07 under the business name of Pratt Well Environmental  
 by (signature) *Steven E. Pratt*

INSTRUCTIONS: Use typewriter or ball point pen. Please press firmly and print clearly. Please fill in blanks, underline or circle the correct answers. Send top three copies to Kansas Department of Health and Environment, Bureau of Water, Geology Section, 1 000 SW Jackson St., Ste. 420, Topeka, Kansas 66612-1367. Telephone: 785/296-5522. Send one to Water Well Owner and retain one for your records.