


1 LOCATION OF WATER WELL: County: Kiowa	Fraction SW ^{1/4} NE ^{1/4} SW ^{1/4}	Section 16	Number	Township 28	Number	Range 18	Number EW
--	---	---------------	--------	----------------	--------	-------------	--------------

Distance and direction from nearest town or city street address of well if located within city?
 W. Kansas Ave. and Grove St., Greensburg, KS

2 WATER WELL OWNER: Coastal Mart Inc. #2509 RR #, St. Address, Box # 2 N. Nevada City, State, ZIP Code Colorado Springs, CO 80903	Board of Agriculture, Division of Water Resources Application Number:
---	--

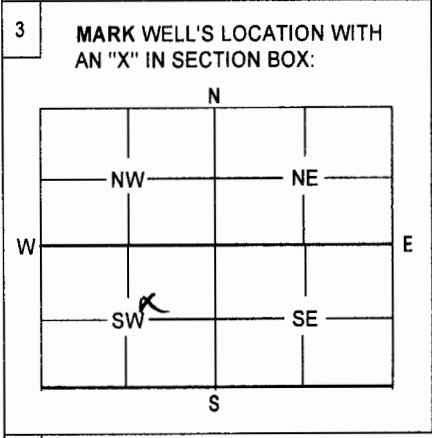

4 DEPTH OF WELL 95.6 ft. WELL'S STATIC WATER LEVEL 87 ft. WELL WAS USED AS: <table style="width:100%; border: none;"> <tr> <td style="width:33%;">1 Domestic</td> <td style="width:33%;">5 Public Water Supply</td> <td style="width:33%;">9 Dewatering</td> </tr> <tr> <td>2 Irrigation</td> <td>6 Oil Field Water Supply</td> <td>10 Monitoring Well</td> </tr> <tr> <td>3 Feedlot</td> <td>7 Domestic (Lawn & Garden)</td> <td>11 Injection Well</td> </tr> <tr> <td>4 Industrial</td> <td>8 Air Conditioning</td> <td>12 Other</td> </tr> </table>	1 Domestic	5 Public Water Supply	9 Dewatering	2 Irrigation	6 Oil Field Water Supply	10 Monitoring Well	3 Feedlot	7 Domestic (Lawn & Garden)	11 Injection Well	4 Industrial	8 Air Conditioning	12 Other	Was a chemical / bacteriological sample submitted to Department? Yes No <input checked="" type="checkbox"/> X if yes, mo/day/yr sample was submitted Water Well Disinfected: Yes No <input checked="" type="checkbox"/> X

5 TYPE OF BLANK CASING USED:

1 Steel	3 RMP (SR)	5 Wrought	7 Fiberglass	9 Other (Specify below)
<input checked="" type="checkbox"/> PVC	4 ABS	6 Asbestos-Cement	8 Concrete Tile	

Blank casing diameter 2 in. Was casing pulled? Yes X No If yes, how much 4'
 Casing height above or below land surface 4' below in.

6 GROUT PLUG MATERIAL: 1 Neat cement 2 Cement grout Bentonite Other Topsoil

Grout Plug Intervals: From 95.6 ft. to 3 ft., From 3 ft. to 0 ft., From to ft.

What is the nearest source of possible contamination:

1 Septic tank	6 Seepage pit	11 Fuel storage
2 Sewer lines	7 Pit privy	12 Fertilizer storage
3 Watertight sewer lines	8 Sewage lagoon	13 Insecticide storage
4 Lateral lines	9 Feedyard	14 Abandoned water well
5 Cess pool	10 Livestock pens	15 Oil well/Gas well
		16 Other (specify below)

Direction from well? 999 How many feet? 999

FROM	TO	PLUGGING MATERIALS
95.6	3	3/8 Bentonite chips
3	0	Topsoil
		MW-16

7 CONTRACTOR'S OF LANDOWNER'S CERTIFICATION: This water well was plugged under my jurisdiction and was completed on (mo/day/year) 4-11-07 and this record is true to the best of my knowledge and belief. Kansas Water Well Contractor's License No. 665 This Water Well Record was completed on (mo/day/year) 4-27-07
 by (signature) Steven E. Bell under the business name of Pratt Well Environmental

INSTRUCTIONS: Use typewriter or ball point pen. Please press firmly and print clearly. Please fill in blanks, underline or circle the correct answers. Send top three copies to Kansas Department of Health and Environment, Bureau of Water, Geology Section, 1 000 SW Jackson St., Ste. 420, Topeka, Kansas 66612-1367. Telephone: 785/296-5522. Send one to Water Well Owner and retain one for your records.