


1 LOCATION OF WATER WELL: Fraction Section Number Township Number Range Number
 County: Kiowa SW 1/4 NE 1/4 SW 1/4 16 28 18 E/W

Distance and direction from nearest town or city street address of well if located within city?
 W. Kansas Ave. and Grove St., Greensburg, KS

2 WATER WELL OWNER: Coastal Mart Inc. #2509
 RR #, St. Address, Box # 2 N. Nevada Board of Agriculture, Division of Water Resources
 City, State, ZIP Code Colorado Springs, CO 80903 Application Number:

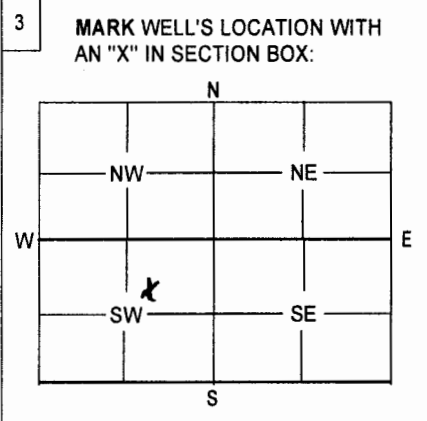

4 DEPTH OF WELL 98.5 ft.
 WELL'S STATIC WATER LEVEL 90.00 ft.
 WELL WAS USED AS:
 1 Domestic 5 Public Water Supply 8 Dewatering
 2 Irrigation 6 Oil Field Water Supply 10 Monitoring Well
 3 Feedlot 7 Domestic (Lawn & Garden) 11 Injection Well
 4 Industrial 8 Air Conditioning 12 Other
 Was a chemical / bacteriological sample submitted to Department? Yes No
 if yes, mo/day/yr sample was submitted
 Water Well Disinfected: Yes No

5 TYPE OF BLANK CASING USED:
 1 Steel 3 RMP (SR) 5 Wrought 7 Fiberglass 9 Other (Specify below)
 2 PVC 4 ABS 6 Asbestos-Cement 8 Concrete Tile
 Blank casing diameter 4 in. Was casing pulled? Yes No If yes, how much 2'
 Casing height above or below land surface 2' below in.

6 GROUT PLUG MATERIAL: 1 Neat cement 2 Cement grout 3 Bentonite 4 Other Cement
 Grout Plug Intervals: From 98.5 ft. to 3 ft., From 3 ft. to 0 ft., From to to ft.
 What is the nearest source of possible contamination:
 1 Septic tank 6 Seepage pit 11 Fuel storage 16 Other (specify below)
 2 Sewer lines 7 Pit privy 12 Fertilizer storage
 3 Watertight sewer lines 8 Sewage lagoon 13 Insecticide storage
 4 Lateral lines 9 Feedyard 14 Abandoned water well
 5 Cess pool 10 Livestock pens 15 Oil well/Gas well
 Direction from well? 999 How many feet? 999

FROM	TO	PLUGGING MATERIALS
98.5	3	3/8 Bentonite chips
3	0	Cement
		SVE-1

7 CONTRACTOR'S OF LANDOWNER'S CERTIFICATION: This water well was plugged under my jurisdiction and was completed on (mo/day/year) 4-11-07 and this record is true to the best of my knowledge and belief. Kansas Water Well Contractor's License No. 665 This Water Well Record was completed on (mo/day/year) 4-27-07 under the business name of Pratt Well Environmental
 by (signature) *Steven E. Gell*

INSTRUCTIONS: Use typewriter or ball point pen. Please press firmly and print clearly. Please fill in blanks, underline or circle the correct answers. Send top three copies to Kansas Department of Health and Environment, Bureau of Water, Geology Section, 1 000 SW Jackson St., Ste. 420, Topeka, Kansas 66612-1367. Telephone: 785/296-5522. Send one to Water Well Owner and retain one for your records.