


1	LOCATION OF WATER WELL:	Fraction	Section Number	Township Number	Range Number
	County: Kiowa	NE 1/4 NW 1/4 SE 1/4	16	28	18W

Distance and direction from nearest town or city street address of well if located within city?
NE corner of courthouse, Greensburg, Ks.

2 WATER WELL OWNER: **G.R.T.I. c/o Galen Streich**
 RR #, St. Address, Box #: **1226 Camelot Dr.** Board of Agriculture, Division of Water Resources
 City, State, ZIP Code : **Brookings, SD 57006** Application Number:

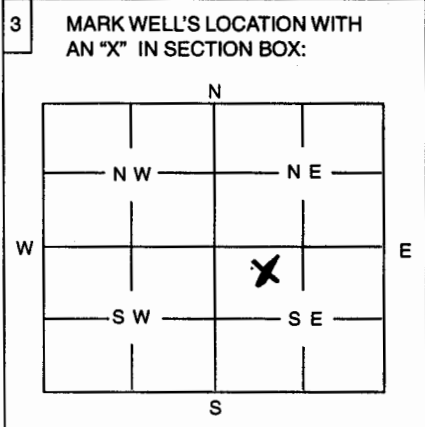

4 DEPTH OF WELL**1 @ 300**..... ft
 WELL'S STATIC WATER LEVEL**60-70**..... ft.

WELL WAS USED AS:

1 Domestic	5 Public Water Supply	9 Dewatering
2 Irrigation	6 Oil Field Water Supply	10 Monitoring Well
3 Feedlot	7 Domestic (Lawn & Garden)	11 Injection Well
4 Industrial	8 Air Conditioning	<input checked="" type="checkbox"/> Other Geo-thermal

Was a chemical / bacteriological sample submitted to Department? Yes No**X**.....
 If yes, mo/day/yr sample was submitted

Water Well Disinfected: Yes No**X**.....

5 TYPE OF BLANK CASING USED:

1 Steel	3 RMP (SR)	5 Wrought	7 Fiberglass	<input checked="" type="checkbox"/> Other (Specify below)
2 PVC	4 ABS	6 Asbestos-Cement	8 Concrete Tile	Polyethylene

Blank casing diameter.....**1**..... in. Was casing pulled? Yes No If yes, how much

Casing height above or below land surface in.

6 GROUT PLUG MATERIAL: 1 Neat cement 2 Cement grout Bentonite 4 Other

Grout Plug Intervals: From**0**..... ft. to**300**..... ft., From ft. to ft., From to ft.

What is the nearest source of possible contamination:

1 Septic tank	6 Seepage pit	11 Fuel storage	16 Other (specify below)
2 Sewer lines	7 Pit privy	12 Fertilizer storage
<input checked="" type="checkbox"/> Watertight sewer lines	8 Sewage lagoon	13 Insecticide storage
4 Lateral lines	9 Feedyard	14 Abandoned water well
5 Cess Pool	10 Livestock pens	15 Oil well/Gas well

Direction from well? ...**North**..... How many feet?**100**.....

FROM	TO	Log
		XXXXXXXXXXXX
0	3	Topsoil
3	62	Clay, silty-brown/red
62	112	Sand, fine to coarse w/gravel
112	118	Clay, brown
118	120	Sandrock
120	138	Sandstone, tan
138	300	Shale, gray w/hard streaks

7 CONTRACTOR'S OR LANDOWNER'S CERTIFICATION: This water well was plugged under my jurisdiction and was completed on (mo/day/year)**2/27/08**..... and this record is true to the best of my knowledge and belief. Kansas Water Well Contractor's License No.**138**..... This Water Well Record was completed on (mo/day/year)**3/4/08**..... under the business name of **Peterson Irrigation, Inc.** by (signature) *Mike Peterson*

INSTRUCTIONS: Use typewriter or ball point pen. Please press firmly and print clearly. Please fill in blanks, underline or circle the correct answers. Send top three copies to Kansas Department of Health and Environment, Bureau of Water, Topeka, Kansas 66620-0001. Telephone: 785/296-3565. Send one to Water Well Owner and retain one for your records.