


1	LOCATION OF WATER WELL:	Fraction	Section Number	Township Number	Range Number
	County: Kiowa	SE 1/4 NE 1/4 SW 1/4	16	28	18W

Distance and direction from nearest town or city street address of well if located within city?
City limits- 204 W. Wisconsin, Greensburg, Ks.

2 WATER WELL OWNER: **Studio 804 c/o Evans Energy**
 RR #, St. Address, Box #: **204 W. Wisconsin** Board of Agriculture, Division of Water Resources
 City, State, ZIP Code : **Greensburg, Ks. 67054** Application Number:

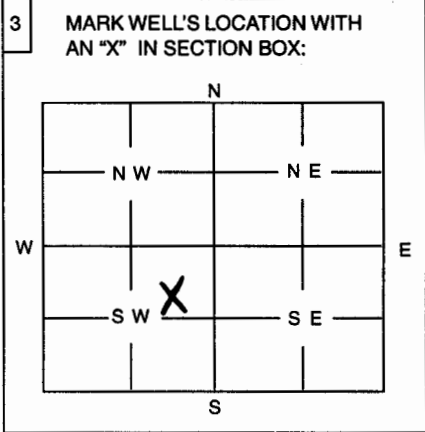

4 DEPTH OF WELL **3 @ 200** ft
 WELL'S STATIC WATER LEVEL **90** ft.
 WELL WAS USED AS:
 1 Domestic 5 Public Water Supply 9 Dewatering
 2 Irrigation 6 Oil Field Water Supply 10 Monitoring Well
 3 Feedlot 7 Domestic (Lawn & Garden) 11 Injection Well
 4 Industrial 8 Air Conditioning Other Geo-Therma
 Was a chemical / bacteriological sample submitted to Department? Yes No
 If yes, mo/day/yr sample was submitted
 Water Well Disinfected: Yes No

5 TYPE OF BLANK CASING USED:
 1 Steel 3 RMP (SR) 5 Wrought 7 Fiberglass Other (Specify below)
~~2 ABS~~ 4 ABS 6 Asbestos-Cement 8 Concrete Tile Polyethylene
 Blank casing diameter **3/4** in. Was casing pulled? Yes No If yes, how much
 Casing height above or below land surface in.

6 GROUT PLUG MATERIAL: 1 Neat cement 2 Cement grout Bentonite 4 Other
 Grout Plug Intervals: From **0** ft. to **200** ft., From **0** ft. to **200** ft., From **0** to **200** ft.
 What is the nearest source of possible contamination:
 1 Septic tank 6 Seepage pit 11 Fuel storage 16 Other (specify below)
 2 Sewer lines 7 Pit privy 12 Fertilizer storage
 Watertight sewer lines 8 Sewage lagoon 13 Insecticide storage
 4 Lateral lines 9 Feedyard 14 Abandoned water well
 5 Cess Pool 10 Livestock pens 15 Oil well/Gas well
 Direction from well? **North** How many feet? **50**

FROM	TO	LOG PLUGGING MATERIALS
0	3	Topsoil
3	61	Clay, red-brown
61	97	Sand, medium to coarse
97	118	Clay, brown
118	147	Sandstone
147	200	Shale, gray

7 CONTRACTOR'S OR LANDOWNER'S CERTIFICATION: This water well was plugged under my jurisdiction and was completed on (mo/day/year) **3/12/08** and this record is true to the best of my knowledge and belief. Kansas Water Well Contractor's License No. **138** This Water Well Record was completed on (mo/day/year) **3/20/08** under the business name of **Peterson Irrigation, Inc.**
 by (signature) *Mike Peterson*

INSTRUCTIONS: Use typewriter or ball point pen. Please press firmly and print clearly. Please fill in blanks, underline or circle the correct answers. Send top three copies to Kansas Department of Health and Environment, Bureau of Water, Topeka, Kansas 66620-0001. Telephone: 785/296-3565. Send one to Water Well Owner and retain one for your records.