


1 LOCATION OF WATER WELL: County: Kiowa	Fraction SW ¼ NW ¼SW ¼	Section 16	Number 28	Township 28	Range 18W
---	----------------------------------	----------------------	---------------------	-----------------------	---------------------

Distance and direction from nearest town or city street address of well if located within city?
214 S. CHERRY

2 WATER WELL OWNER: **Ferrell Allison**
 RR #, St. Address, Box #: **PO Box 238**
 City, State, ZIP Code : **Haviland, Ks. 67059**
 Board of Agriculture, Division of Water Resources
 Application Number:

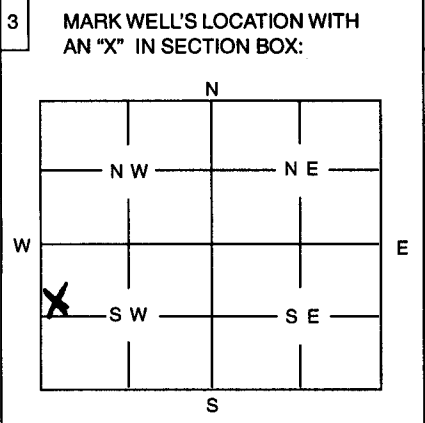

4 DEPTH OF WELL1 @ 193..... ft 2 @ 205 ft, 1 @ 194 ft.
 WELL'S STATIC WATER LEVEL **.80**..... ft.
 WELL WAS USED AS:
 1 Domestic 5 Public Water Supply 9 Dewatering
 2 Irrigation 6 Oil Field Water Supply 10 Monitoring Well
 3 Feedlot 7 Domestic (Lawn & Garden) 11 Injection Well
 4 Industrial 8 Air Conditioning Other **Geo-Thermal**

Was a chemical / bacteriological sample submitted to Department? Yes No **X**.....
 If yes, mo/day/yr sample was submitted

Water Well Disinfected: Yes No **X**.....

5 TYPE OF BLANK CASING USED:
 1 Steel 3 RMP (SR) 5 Wrought 7 Fiberglass Other (Specify below)
 2 PVC 4 ABS 6 Asbestos-Cement 8 Concrete Tile **Polyethylene**

Blank casing diameter **3/4** in. Was casing pulled? Yes No If yes, how much

Casing height above or below land surface in.

6 GROUT PLUG MATERIAL: 1 Neat cement 2 Cement grout Bentonite 4 Other

Grout Plug Intervals: From **0** ft. to **193** ft., From **0** ft. to **205** ft., From **0** ft. to **205** ft.

What is the nearest source of possible contamination: **From 0 ft to 194 ft**

1 Septic tank	6 Seepage pit	11 Fuel storage	16 Other (specify below)
2 Sewer lines	7 Pit privy	12 Fertilizer storage	
<input checked="" type="checkbox"/> Watertight sewer lines	8 Sewage lagoon	13 Insecticide storage	
4 Lateral lines	9 Feedyard	14 Abandoned water well	
5 Cess Pool	10 Livestock pens	15 Oil well/Gas well	

Direction from well? **West** How many feet? **120**

FROM	TO	LOG PLUGGING MATERIALS
0	3	Topsoil
3	61	Clay, sandy, red w/fine sand
61	109	Sand, medium to coarse
109	125	Clay, tan
125	205	Shale, gray w/hard layers

7 CONTRACTOR'S OR LANDOWNER'S CERTIFICATION: This water well was plugged under my jurisdiction and was completed on (mo/day/year) **3/10/08** and this record is true to the best of my knowledge and belief. Kansas Water Well Contractor's License No. **138** This Water Well Record was completed on (mo/day/year) **3/17/08** under the business name of **Peterson Irrigation, Inc.** by (signature) *Mike Peterson*

INSTRUCTIONS: Use typewriter or ball point pen. Please press firmly and print clearly. Please fill in blanks, underline or circle the correct answers. Send top three copies to Kansas Department of Health and Environment, Bureau of Water, Topeka, Kansas 66620-0001. Telephone: 785/296-3565. Send one to Water Well Owner and retain one for your records.