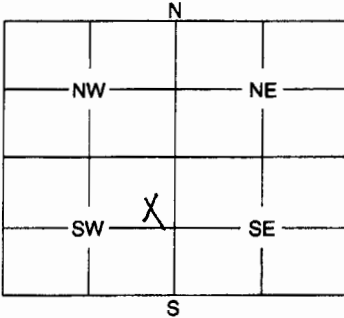


1	LOCATION OF WATER WELL:	Fraction	Section Number	Township Number	Range Number
County:	Kiowa	SE ¼ NE ¼ SW ¼	16	28 S	18 E(W)

Distance and direction from nearest town or city street address of well if located within city?
 110°N and 150°W of NW corner of Kansas & Sycamore, Greensburg

2	WATER WELL OWNER: KOEHN 66	RR #, St. Address, Box #: 13605 W. Maple, Suite 101	Board of Agriculture, Division of Water Resources
	City, State, ZIP Code : Wichita, KS 67235		Application Number:

3	MARK WELL'S LOCATION WITH AN "X" IN SECTION BOX:	4	DEPTH OF WELL90..... ft.	
			WELL'S STATIC WATER LEVEL77.31..... ft.	
			WELL WAS USED AS:	
		1 Domestic	5 Public Water Supply	9 Dewatering
		2 Irrigation	6 Oil Field Water Supply	● Monitoring Well
		3 Feedlot	7 Domestic (Lawn & Garden)	11 Injection Well
		4 Industrial	8 Air Conditioning	12 Other
		Was a chemical / bacteriological sample submitted to Department? Yes No✓.....		
		If yes, mo/day/yr sample was submitted		
		Water Well Disinfected: Yes No✓.....		

5	TYPE OF BLANK CASING USED:
	1 Steel 3 RMP (SR) 5 Wrought 7 Fiberglass 9 Other (Specify below)
	● PVC 4 ABS 6 Asbestos-Cement 8 Concrete Tile
	Blank casing diameter2..... in. Was casing pulled? Yes No✓..... If yes, how much
	Casing height above or below land surface0..... in.

6	GROUT PLUG MATERIAL:	1 Neat cement	2 Cement grout	● Bentonite	● Other ..Native soil.....
	Grout Plug Intervals:	From0..... ft. to3..... ft.,	From3..... ft. to90..... ft.,	From to ft.	
	What is the nearest source of possible contamination:				
	1 Septic tank	6 Seepage pit	11 Fuel storage	16 Other (specify below)	
	2 Sewer lines	7 Pit privy	12 Fertilizer storage		
	3 Watertight sewer lines	8 Sewage lagoon	13 Insecticide storage		
	4 Lateral lines	9 Feedyard	14 Abandoned water well		
	5 Cess pool	10 Livestock pens	15 Oil well/Gas well		
	Direction from well? How many feet?				

FROM	TO	PLUGGING MATERIALS
0	3	Native soil (8")
3	90	Bentonite (4")

MW52
 KDHE #U1 049 13273
 GeoCore #1290

7	CONTRACTOR'S OF LANDOWNER'S CERTIFICATION: This water well was plugged under my jurisdiction and was completed on (mo/day/year)4/25/2008..... and this record is true to the best of my knowledge and belief. Kansas Water Well Contractor's License No.527..... This Water Well Record was completed on (mo/day/year)5/9/2008..... under the business name of GeoCore, Inc. by (signature) <i>Dale Kelly</i>
---	---

INSTRUCTIONS: Use typewriter or ball point pen. Please press firmly and print clearly. Please fill in blanks, underline or circle the correct answers. Send top three copies to Kansas Department of Health and Environment, Bureau of Water, Geology Section, 1000 SW Jackson St., Ste. 420, Topeka, Kansas 66612-1367. Telephone: 785/296-5522. Send one to Water Well Owner and retain one for your records.