


1	LOCATION OF WATER WELL:	Fraction	Section Number	Township Number	Range Number
County:	Kiowa	SW $\frac{1}{4}$ NW $\frac{1}{4}$ SE $\frac{1}{4}$	16	28 S	18

Distance and direction from nearest town or city street address of well if located within city?
 95'N and 90'W of NW corner of Kansas & Sycamore, Greensburg

2	WATER WELL OWNER:	KOEHN 66	Board of Agriculture, Division of Water Resources
RR #, St. Address, Box #:	13605 W. Maple, Suite 101	City, State, ZIP Code	Wichita, KS 67235
Application Number:			

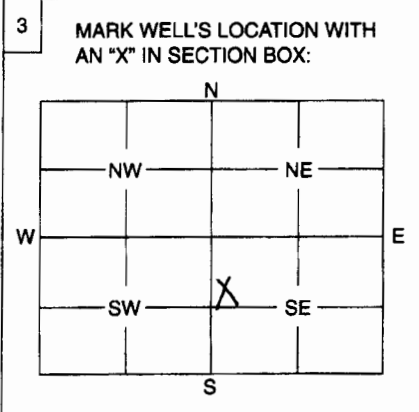

4	DEPTH OF WELL	98.5	ft.
	WELL'S STATIC WATER LEVEL	N/A	ft.
WELL WAS USED AS:			
1 Domestic	5 Public Water Supply	9 Dewatering	
2 Irrigation	6 Oil Field Water Supply	<input checked="" type="radio"/> Monitoring Well	
3 Feedlot	7 Domestic (Lawn & Garden)	11 Injection Well	
4 Industrial	8 Air Conditioning	12 Other	
Was a chemical / bacteriological sample submitted to Department? Yes No <input checked="" type="checkbox"/>			
If yes, mo/day/yr sample was submitted			
Water Well Disinfected: Yes No <input checked="" type="checkbox"/>			

5	TYPE OF BLANK CASING USED:			
1 Steel	3 RMP (SR)	5 Wrought	7 Fiberglass	9 Other (Specify below)
<input checked="" type="radio"/> PVC	4 ABS	6 Asbestos-Cement	8 Concrete Tile	
Blank casing diameter	4	in.	Was casing pulled?	Yes No If yes, how much
Casing height above or below land surface	0	in.		

6	GROUT PLUG MATERIAL:	1 Neat cement	2 Cement grout	<input checked="" type="radio"/> Bentonite	<input checked="" type="radio"/> Other ..Native soil.....												
Grout Plug Intervals:	From	0	ft.	to	3	ft.,	From	3	ft.	to	98.5	ft.,	From		to		ft.
What is the nearest source of possible contamination:																	
1 Septic tank	6 Seepage pit	11 Fuel storage	16 Other (specify below)														
2 Sewer lines	7 Pit privy	12 Fertilizer storage															
3 Watertight sewer lines	8 Sewage lagoon	13 Insecticide storage															
4 Lateral lines	9 Feedyard	14 Abandoned water well															
5 Cess pool	10 Livestock pens	15 Oil well/Gas well															
Direction from well? How many feet?																	

FROM	TO	PLUGGING MATERIALS
0	3	Native soil (8")
3	98.5	Bentonite (4")

MW43
 KDHE #U1 049 13273
 GeoCore #1290

7	CONTRACTOR'S OF LANDOWNER'S CERTIFICATION: This water well was plugged under my jurisdiction and was completed on (mo/day/year) 4/25/2008 and this record is true to the best of my knowledge and belief. Kansas Water Well Contractor's License No. 527 This Water Well Record was completed on (mo/day/year) 5/9/2008 under the business name of Geocore Inc.
by (signature)	<i>Dale Holt</i>

INSTRUCTIONS: Use typewriter or ball point pen. Please press firmly and print clearly. Please fill in blanks, underline or circle the correct answers. Send top three copies to Kansas Department of Health and Environment, Bureau of Water, Geology Section, 1000 SW Jackson St., Ste. 420, Topeka, Kansas 66612-1367. Telephone: 785/296-5522. Send one to Water Well Owner and retain one for your records.