


1	LOCATION OF WATER WELL:	Fraction	Section Number	Township Number	Range Number
County: Kiowa	NE 1/4 NE 1/4 SW 1/4	16	28	18	XW

Distance and direction from nearest town or city street address of well if located within city?
Corner of U.S. 54 & Main St. - Greensburg, Ks.

2 WATER WELL OWNER: **City of Greensburg, Ks.**
 RR #, St. Address, Box #: **c/o Waldinger Corporation** Board of Agriculture, Division of Water Resources
 City, State, ZIP Code: **1630 Baehr Wichita, Ks.** Application Number: **BUSINESS INCUBATOR**

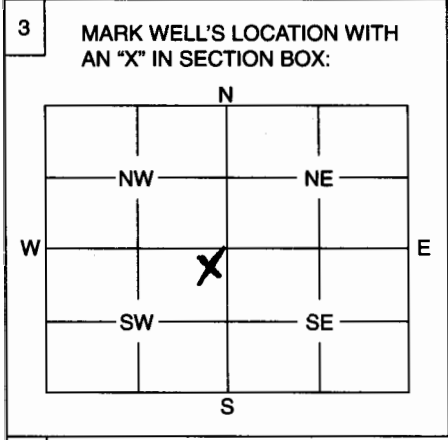

4 DEPTH OF WELL **67209** **21 @ 340** ft.
 WELL'S STATIC WATER LEVEL **103** ft.
 WELL WAS USED AS:
 1 Domestic 5 Public Water Supply 9 Dewatering
 2 Irrigation 6 Oil Field Water Supply 10 Monitoring Well
 3 Feedlot 7 Domestic (Lawn & Garden) 11 Injection Well
 4 Industrial 8 Air Conditioning Other **Geo-thermal**

Was a chemical / bacteriological sample submitted to Department? Yes No **X**.....
 If yes, mo/day/yr sample was submitted

Water Well Disinfected: Yes **X**..... No

5 TYPE OF BLANK CASING USED:
 1 Steel 3 RMP (SR) 5 Wrought 7 Fiberglass Other (Specify below)
 2 PVC 4 ABS 6 Asbestos-Cement 8 Concrete Tile **Polyethylene**

Blank casing diameter **1** in. Was casing pulled? Yes No If yes, how much

6 GROUT PLUG MATERIAL: 1 Neat cement 2 Cement grout **Bentonite (Finished)**

Grout Plug Intervals: From **0** ft. to **340** ft., **X2ft** from ft. to ft., From to ft.

What is the nearest source of possible contamination:
 1 Septic tank 6 Seepage pit 11 Fuel storage 16 Other (specify below)
 2 Sewer lines 7 Pit privy 12 Fertilizer storage
 Watertight sewer lines 8 Sewage lagoon 13 Insecticide storage
 4 Lateral lines 9 Feedyard 14 Abandoned water well
 5 Cess pool 10 Livestock pens 15 Oil well/Gas well

Direction from well? **East** How many feet? **100 ft.**

FROM	TO	PLUGGING MATERIALS
0	3	Topsoil
3	58	Clay, brown
58	119	Sand, med. to coarse
119	129	Sandstone, soft
129	134	Clay, tan
134	340	Shale, gray w/hard spots

7 CONTRACTOR'S OF LANDOWNER'S CERTIFICATION: This water well was plugged under my jurisdiction and was completed on (mo/day/year) **8/22/08** and this record is true to the best of my knowledge and belief. Kansas Water Well Contractor's License No. **138** This Water Well Record was completed on (mo/day/year) **9/4/08** under the business name of **Peterson Irrigation, Inc.**
 by (signature) *Mike Peterson*

INSTRUCTIONS: Use typewriter or ball point pen. Please press firmly and print clearly. Please fill in blanks, underline or circle the correct answers. Send top three copies to Kansas Department of Health and Environment, Bureau of Water, Geology Section, 1000 SW Jackson St., Ste. 420, Topeka, Kansas 66612-1367. Telephone: 785/296-5522. Send one to Water Well Owner and retain one for your records.