


1 LOCATION OF WATER WELL: County: Kiowa	Fraction SW 1/4 NW 1/4 SE 1/4	Section Number 16	Township Number T 28 S	Range Number R 18 E/W
---	---	-----------------------------	----------------------------------	---------------------------------

Distance and direction from nearest town or city street address of well if located within city?
102 E. Kansas, Greensburg

2 WATER WELL OWNER: **Farmer's Grain & Supply**
 RR#, St. Address, Box # : **102 E. Kansas Ave.** Board of Agriculture, Division of Water Resources
 City, State, ZIP Code : **Greensburg, Kansas 67054** Application Number:

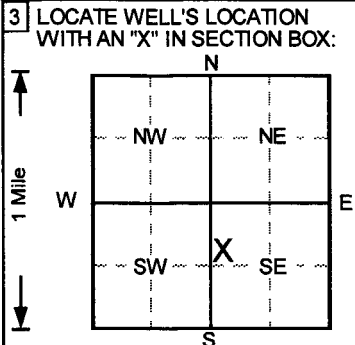

4 DEPTH OF COMPLETED WELL **97** ft. ELEVATION:

Depth(s) Groundwater Encountered 1. ft. 2. ft. 3. ft.

WELL'S STATIC WATER LEVEL ft. below land surface measured on mo/day/yr

Pump test data: Well water was **NA** ft. after hours pumping gpm

Est. Yield **NA** gpm: Well water was ft. after hours pumping gpm

Bore Hole Diameter **8** in. to **97** ft., and in. to ft.

WELL WATER TO BE USED AS: 5 Public water supply 8 Air conditioning 11 Injection well
 1 Domestic 3 Feedlot 6 Oil field water supply 9 Dewatering **12** Other (Specify below)
 2 Irrigation 4 Industrial 7 Lawn and garden only 10 Monitoring well **Air sparge**

Was a chemical/bacteriological sample submitted to Department? Yes.....No ; If yes, mo/day/yr sample was submitted

Water Well Disinfected? Yes No

5 TYPE OF BLANK CASING USED: 5 Wrought iron 8 Concrete tile CASING JOINTS: Glued Clamped
 1 Steel 3 RMP (SR) 6 Asbestos-Cement 9 Other (specify below) Welded
2 PVC 4 ABS 7 Fiberglass Threaded.

Blank casing diameter **2** in. to **95** ft., Dia in. to ft., Dia in. to ft.

Casing height above land surface in., weight lbs./ft. Wall thickness or gauge No. **Sch. 40**

TYPE OF SCREEN OR PERFORATION MATERIAL **7** PVC 10 Asbestos-cement
 1 Steel 3 Stainless steel 5 Fiberglass **8** RMP (SR) 11 Other (specify)
 2 Brass 4 Galvanized steel 6 Concrete tile 9 ABS 12 None used (open hole)

SCREEN OR PERFORATION OPENINGS ARE: 5 Gauzed wrapped 8 Saw cut 11 None (open hole)
 1 Continuous slot **3** Mill slot 6 Wire wrapped 9 Drilled holes
 2 Louvered shutter 4 Key punched 7 Torch cut 10 Other (specify)

SCREEN-PERFORATED INTERVALS: From **95** ft. to **97** ft., From ft. to ft.
 From ft. to ft., From ft. to ft.

GRAVEL PACK INTERVALS: From **93** ft. to **97** ft., From ft. to ft.
 From ft. to ft., From ft. to ft.

6 GROUT MATERIAL: 1 Neat cement 2 Cement grout **3** Bentonite **4** Other **Concrete**

Grout intervals: From **4** ft. to **80** ft., From **80** ft. to **95** ft., From ft. to ft.

What is the nearest source of possible contamination:
 1 Septic tank 4 Lateral lines 7 Pit privy 10 Livestock pens 14 Abandoned water well
 2 Sewer lines 5 Cess pool 8 Sewage lagoon 11 Fuel storage 15 Oil well/Gas well
 3 Watertight sewer lines 6 Seepage pit 9 Feedyard 12 Fertilizer storage 16 Other (specify below)
 13 Insecticide storage

Direction from well? How many feet?

FROM	TO	LITHOLOGIC LOG	FROM	TO	PLUGGING INTERVALS
0	1	Gravel, sand, clay,			
1	6	Silt, sl. clayey, moist, Brown			
6	9	Sand (vf-f), no odor, Red Brown			
9	20	Clay, v. silty, sandy, Lt. Red Brown			
20	25	Sand (vf-f), no odor, Lt. Brown			
25	38	Silt, sandy (vf), moist, Brown			
38	44	Clay, white calc. mat., Yellow Brown			
44	55	Sand (vf-c), clay stringers, Lt. Brown			
55	60	Silt, sl. sandy (vf), no odor, Lt. Brown			
60	68	Sand (vf-c), moist, Brown			
68	75	Sand (f-c) w/f gravel, moist, Brown			
75	85	Sand (f-c) w/f-m gravel, moist, Brown			
85	97	Sand (f-c) w/f-m gravel, Brown			
					AS17, Tag # 0042531, Flushmount
					Project Name: GF - Farmer's Grain Supply
					GeoCore # 1322, KDHE # U1 049 00461

7 CONTRACTOR'S OR LANDOWNER'S CERTIFICATION: This water well was **(1)** constructed, (2) reconstructed, or (3) plugged under my jurisdiction and was completed on (mo/day/year) **8/26/2008** and this record is true to the best of my knowledge and belief.
 Kansas Water Well Contractor's License No. **527** This Water Well Record was completed on (mo/day/yr) **9/9/2008**
 under the business name of **GeoCore, Inc.** by (signature) *Joe [Signature]*

OFFICE USE ONLY

T

R

EW

SEC.

1/4

1/4

1/4