

**WATER WELL RECORD**

**Form WWC-5**

Division of Water Resources; App. No.

20090298


<b>1 LOCATION OF WATER WELL:</b> County: <u>Kiowa</u>	Fraction <u>NE 1/4 NW 1/4 SE 1/4</u>	Section Number <u>4</u>	Township Number <u>T 28 S</u>	Range Number <u>R 18w E/W</u>
--	---	----------------------------	----------------------------------	----------------------------------

Distance and direction from nearest town or city street address of well if located within city?  
1N og Greensburg, KS

**Global Positioning Systems** (decimal degrees, min. of 4 digits)  
 Latitude: \_\_\_\_\_  
 Longitude: \_\_\_\_\_  
 Elevation: \_\_\_\_\_  
 Datum: \_\_\_\_\_  
 Data Collection Method: \_\_\_\_\_

**2 WATER WELL OWNER:** Tim Nace  
 RR#, St. Address, Box # : 1040 N. Main  
 City, State, ZIP Code : Greensburg, KS 67054

**3 LOCATE WELL'S LOCATION WITH AN "X" IN SECTION BOX:**

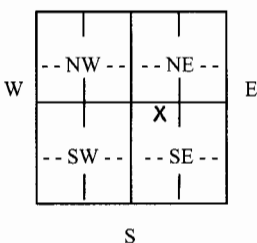

**4 DEPTH OF COMPLETED WELL** ..... 120 ..... ft.

Depth(s) Groundwater Encountered (1).....70..... ft. (2)..... ft. (3)..... ft.  
 WELL'S STATIC WATER LEVEL.....70..... ft. below land surface measured on mo/day/yr. 11/05/09..  
 Pump test data: Well water was.....ft. after..... hours pumping..... gpm  
 Est. Yield....60..gpm: Well water was.....ft. after..... hours pumping..... gpm  
 WELL WATER TO BE USED AS: 5 Public water supply 8 Air conditioning 11 Injection well  
 1 Domestic 3 Feedlot 6 Oil field water supply 9 Dewatering 12 Other (Specify below)  
 2 Irrigation 4 Industrial 7 Domestic (lawn & garden) 10 Monitoring well .....

Was a chemical/bacteriological sample submitted to Department? Yes ..... No .....; If yes, mo/day/yrs  
 Sample was submitted..... Water well disinfected? Yes ..... No .....

**5 TYPE OF CASING USED:**

1 Steel	3 RMP (SR)	5 Wrought Iron	6 Asbestos-Cement	7 Fiberglass	8 Concrete tile	9 Other (specify below)	CASING JOINTS: Glued..... Clamped.....
<u>2 PVC</u>	4 ABS						Welded.....
							Threaded.....

Blank casing diameter ..... 5 ..... in. to ..... 80 ..... ft., Diameter ..... in. to ..... ft., Diameter ..... in. to ..... ft.  
 Casing height above land surface..... 12 ..... in., Weight 2.8 ..... lbs./ft. Wall thickness or guage No. .. Sch 40 .....

TYPE OF SCREEN OR PERFORATION MATERIAL:

1 Steel	3 Stainless Steel	5 Fiberglass	<u>7 PVC</u>	9 ABS	11 Other (Specify) .....
2 Brass	4 Galvanized Steel	6 Concrete tile	8 RM (SR)	10 Asbestos-Cement	12 None used (open hole)

SCREEN OR PERFORATION OPENINGS ARE:

1 Continuous slot	3 Mill slot	5 Gauzed wrapped	7 Torch cut	9 Drilled holes	11 None (open hole)
2 Louvered shutter	4 Key punched	6 Wire wrapped	<u>8 Saw cut</u>	10 Other (specify) .....	

SCREEN-PERFORATED INTERVALS: From..... 80 ..... ft. to ..... 120 ..... ft., From ..... ft. to ..... ft.  
 From..... ft. to ..... ft., From ..... ft. to ..... ft.

GRAVEL PACK INTERVALS: From..... 20 ..... ft. to ..... 120 ..... ft., From ..... ft. to ..... ft.  
 From..... ft. to ..... ft., From ..... ft. to ..... ft.

**6 GROUT MATERIAL:** 1 Neat cement 2 Cement grout 3 Bentonite 4 Other .....

Grout Intervals: From ... 0 ..... ft. to ..... 20 ..... ft., From ..... ft. to ..... ft., From ..... ft. to ..... ft.

What is the nearest source of possible contamination:

1 Septic tank	4 Lateral lines	7 Pit privy	10 Livestock pens	13 Insecticide storage	16 Other (specify below)
2 Sewer lines	5 Cess pool	8 Sewage lagoon	11 Fuel storage	14 Abandoned water well	
3 Watertight sewer lines	6 Seepage pit	9 Feedyard	12 Fertilizer storage	<u>15 Oil well/gas well</u>	

Direction from well? ..... East, Northeast ..... How many feet? ... 85 .....

FROM	TO	LITHOLOGIC LOG	FROM	TO	PLUGGING INTERVALS
0	5	top sand			
5	43	clay			
43	90	sand and gravel			Nace 1-4
90	92	clay			
92	119	sand and gravel with clay streaks			Sterling Drilling Company
119	120	clay			P. O. Box 1006
					Pratt, KS 67124

**7 CONTRACTOR'S OR LANDOWNER'S CERTIFICATION:** This water well was (1) constructed, (2) reconstructed, or (3) plugged under my jurisdiction and was completed on (mo/day/year) ..... 11/05/09 ..... and this record is true to the best of my knowledge and belief.  
 Kansas Water Well Contractor's License No. ... 186 ..... This Water Well Record was completed on (mo/day/year) 11/14/09 .....  
 under the business name of Kelly's Water Well Service, Inc. by (signature) Kathleen R. Wood

**INSTRUCTIONS:** Use typewriter or ball point pen. PLEASE PRESS FIRMLY and PRINT clearly. Please fill in blanks, underline or circle the correct answers. Send top three copies to Kansas Department of Health and Environment, Bureau of Water, Geology Section, 1000 SW Jackson St., Suite 420, Topeka, Kansas 66612-1367. Telephone 785-296-5522. Send one to WATER WELL OWNER and retain one for your records. Fee of \$5.00 for each constructed well. Visit us at <http://www.kdheks.gov/waterwell/index.html>.

# STERLING DRILLING COMPANY

P.O. BOX 1006

PRATT, KANSAS 67124

(620) 672-9508 Phone/(620) 672-9509 Fax

# COPY

July 1, 2010

Kansas Department of Health and Environment  
Bureau of Water  
Attn: Richard Harper  
1000 SW Jackson, Suite 420  
Topeka, Kansas 66612-1367

**RE: Water Well Transferred from Sterling Drilling Company to the Landowner**


Richard Harper:

I have listed below the water well that we have transferred to the landowner.

<u>Name</u>	<u>Water Well Permit #</u>	<u>Sec-Town-Rge</u>	<u>County</u>
Nace #1-4	20090298	4- 28s -18w	Kiowa
Cromer	20090271	9- 29s -13w	Pratt

Please call me at the letterhead phone number if you have any questions.

Sincerely,

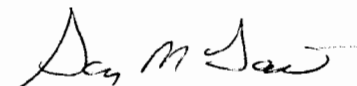

Gary M. Talbott,  
Operations Manager  
Sterling Drilling Company

RECEIVED

JUL 06 2010

BUREAU OF WATER



P.O. BOX 1006  
PRATT, KANSAS 67124  
(620) 672-9508 Phone/(620) 672-9509 Fax

**COPY**

**WATER WELL ACCEPTANCE AGREEMENT**

Water Well Name: Nace #1-4

Water Well Location: Section 4 Township 28s 11w 18w  
County Kiowa

Water Well Location (footage) 1350' FSL & 1375' FEL Section 4

Board of Agriculture, Division of Water Resources Application Number: 20090298

Central Kansas Local Environmental Planning Group Permit Number: NA

This agreement between Sterling Drilling Company, P.O. Box 1006, Pratt, Kansas, 67124, and

Tim Nace

certifies that they accept the above listed water well that was drilled by Kelly's Water Well Service, Inc., Great Bend, Kansas, located approximately 1350' FSL & 1375' FEL of Section 4 Township 28s Range 18w Kiowa County, Kansas for domestic use only and when the well is no longer needed agrees to plug the well in accordance with the State Regulation KAR 28-30-7.

By signing this agreement, landowner releases Sterling Drilling Company from any further responsibilities relating to the water well described above. And agrees to allow Sterling Drilling and/or Strata use of this water well free of charge for any future drilling <sup>cont</sup> ~~(36 months TN)~~ operations within 3/4 mile of this water well. Sterling Drilling and or Strata would be responsible for the filing and payment of any required county and state permits required for use of the water at that time.

6/18/2010

Date

Gary M. Talbott  
Gary M. Talbott, Operations Manager  
Sterling Drilling Company

6/25/10

Date

Tim Nace  
Tim Nace  
Landowner

Copy of the WWC-5 permit attached