

WATER WELL PLUGGING RECORD Form WWC-5P

KSA 82a-1212 ID NO.

94364

1 LOCATION OF WATER WELL: Fraction 1/4 SE 1/4 NW 1/4 SE 1/4 Section Number 16 Township Number T 28 S Range Number 18 E W
 County: Kiowa

Street/Rural Address of Well Location; if unknown, distance & direction from nearest town or intersection: If at owner's address, check here


Global Positioning Systems (GPS) information:
 Latitude: _____ (in decimal degrees)
 Longitude: _____ (in decimal degrees)
 Elevation: _____

Datum: WGS84, NAD83, NAD27
 Collection Method:

2 WATER WELL OWNER: Farmer's Grain & Supply
 RR#, St. Address, Box #: 102 E. Kansas Ave.
 City, State ZIP Code: Greensburg, KS 67054

GPS unit (Make/Model): _____
 Digital Map/Photo, Topographic Map, Land Survey
 Est. Accuracy: < 3 m, 3-5 m, 5-15 m, > 15 m

3 MARK WELL'S LOCATION WITH AN "X" IN SECTION BOX:

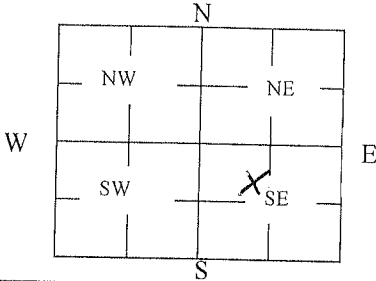

4 DEPTH OF WELL 92 **ft.**

WELL'S STATIC WATER LEVEL _____ ft

WELL WAS USED AS:

- Domestic
- Irrigation
- Feedlot
- Industrial
- Public Water Supply
- Oil Field Water Supply
- Domestic (Lawn & Garden)
- Air Conditioning
- Dewatering
- Monitoring
- Injection Well
- Other _____

Was a chemical/bacteriological sample submitted to Department? Yes No

5 TYPE OF BLANK CASING USED:

- Steel
- PVC
- RMP (SR)
- ABS
- Wrought
- Asbestos-Cement
- Fiberglass
- Concrete Tile
- Other (Specify below) _____

Blank casing diameter 2 in. Was casing pulled? Yes No If yes, how much Top 3 Feet
 Casing height above or below land surface _____ in.

6 GROUT PLUG MATERIAL: Neat cement Cement grout Bentonite Other Concrete

Grout Plug Intervals: From 0 ft. to 3 ft., From 3 ft. to 92 ft., From _____ to _____ ft.

What is the nearest source of possible contamination:

- Septic tank
 - Sewer lines
 - Watertight sewer lines
 - Lateral lines
 - Cess pool
 - Seepage pit
 - Pit privy
 - Sewage lagoon
 - Feedyard
 - Livestock pens
 - Fuel Storage
 - Fertilizer storage
 - Insecticide storage
 - Abandoned water well
 - Oil well/Gas well
 - Other (specify below) _____
- Direction from well? _____
 How many feet? _____

FROM	TO	PLUGGING MATERIALS	FROM	TO	PLUGGING MATERIALS
0	3	Concrete			
3	92	Bentonite			
					FMW-7

7 CONTRACTOR'S OR LANDOWNER'S CERTIFICATION: This water well was plugged under my jurisdiction and was completed on (mo/day/year) 6/2/2011 and this record is true to the best of my knowledge and belief. Kansas Water Well Contractor's License No. _____ This Water Well Record was completed on (mo/day/year) 6/16/2011 under the business name of GreenField Contractors, Inc. by (signature) Melissa D. Malheur

INSTRUCTIONS: Use typewriter or ballpoint pen. Please press firmly and print clearly. Please fill in blanks, underline or circle the correct answers. Send top three copies to Kansas Department of Health and Environment, Bureau of Water, Geology Section, 1000 SW Jackson St., Ste. 420, Topeka, Kansas 66612-1367. Telephone: 785/296-5524. Send one to Water Well Owner and retain one for your records. Visit us at <http://www.kdheks.gov/waterwell/index.html>.

Check one: White Copy Blue Copy Pink Copy