


1] LOCATION OF WATER WELL: County: <b>Kiowa</b>	Fraction <b>SW 1/4 NW 1/4 SE 1/4</b>	Section Number <b>16</b>	Township Number <b>T 28 S</b>	Range Number <b>R 18 E/W</b>
--	---	-----------------------------	----------------------------------	---------------------------------

Distance and direction from nearest town or city street address of well if located within city?  
**102 E. Kansas, Greensburg**

2] WATER WELL OWNER: **Southern Plains Coop**  
 RR#, St. Address, Box # : **PO Box 128** Board of Agriculture, Division of Water Resources  
 City, State, ZIP Code : **Lewis, Kansas 67552** Application Number:

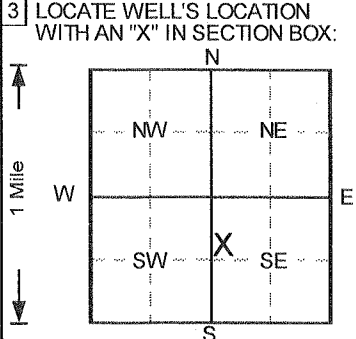

4] DEPTH OF COMPLETED WELL **100** ft ELEVATION: .....

Depth(s) Groundwater Encountered 1. .... ft. 2. .... ft. 3. .... ft.

WELL'S STATIC WATER LEVEL **87.22** ft. below land surface measured on mo/day/yr **2/3/2014**

Pump test data: Well water was **NA** ft. after ..... hours pumping ..... gpm

Est. Yield **NA** gpm: Well water was ..... ft. after ..... hours pumping ..... gpm

Bore Hole Diameter **8** in. to **100** ft., and ..... in. to ..... ft.

WELL WATER TO BE USED AS:

5 Public water supply	8 Air conditioning	11 Injection well
1 Domestic	3 Feedlot	6 Oil field water supply
2 Irrigation	4 Industrial	7 Lawn and garden only
		10 Monitoring well

Was a chemical/bacteriological sample submitted to Department? Yes.....No  If yes, mo/day/yr sample was submitted Water Well Disinfectant? Yes No

5] TYPE OF BLANK CASING USED:

1 Steel	3 RMP (SR)	5 Wrought iron	8 Concrete tile	CASING JOINTS: Glued ..... Clamped .....
2 PVC	4 ABS	6 Asbestos-Cement	9 Other (specify below)	Welded .....
		7 Fiberglass		Threaded. <input checked="" type="checkbox"/>

Blank casing diameter **2** in. to **80** ft., Dia ..... in. to ..... ft.

Casing height above land surface ..... in., weight ..... lbs./ft. Wall thickness or gauge No. **Sch. 40**

TYPE OF SCREEN OR PERFORATION MATERIAL:

1 Steel	3 Stainless steel	5 Fiberglass	8 RMP (SR)	10 Asbestos-cement
2 Brass	4 Galvanized steel	6 Concrete tile	9 ABS	11 Other (specify) .....
				12 None used (open hole)

SCREEN OR PERFORATION OPENINGS ARE:

1 Continuous slot	3 Mill slot	5 Gauzed wrapped	8 Saw cut	11 None (open hole)
2 Lowered shutter	4 Key punched	6 Wire wrapped	9 Drilled holes	
		7 Torch cut	10 Other (specify) .....	

SCREEN-PERFORATED INTERVALS: From **80** ft. to **100** ft., From ..... ft. to ..... ft.

GRAVEL PACK INTERVALS: From **77** ft. to **100** ft., From ..... ft. to ..... ft.

6] GROUT MATERIAL: **1** Neat cement **2** Cement grout **3** Bentonite **4** Other **Concrete**

Grout Intervals: From **0** ft. to **1** ft., From **1** ft. to **73** ft., From **73** ft. to **77** ft.

What is the nearest source of possible contamination:

1 Septic tank	4 Lateral lines	7 Pit privy	10 Livestock pens	14 Abandoned water well
2 Sewer lines	5 Cess pool	8 Sewage lagoon	11 Fuel storage	15 Oil well/Gas well
3 Watertight sewer lines	6 Seepage pit	9 Feedyard	12 Fertilizer storage	16 Other (specify below)
			13 Insecticide storage	

Direction from well? How many feet?

FROM	TO	LITHOLOGIC LOG	FROM	TO	PLUGGING INTERVALS
0	0.5	Concrete,			
0.5	5	Clay, silty, Dark Brown			
5	20	Silt, sandy, sl. clayey, Brown			
20	34	Silt, sl. sandy, v. sl. clayey, Brown			
34	41	Clay, silty to v. silty, Brown			
41	45	Silt, sl. clayey, Brown			
45	52	Clay, silty, sand stringers, Brown			
52	67	Sand, vf-f, silty, sl. clayey, Brown			
67	82	Sand, vf-c w/f-m gravel, Brown			
82	100	Sand, f-c w/f-c gravel, Brown			
					MW46, Flushmount

7] CONTRACTOR'S OR LANDOWNER'S CERTIFICATION: This water well was **(1)** constructed, (2) reconstructed, or (3) plugged under my jurisdiction and was completed on (mo/day/year) **6/6/2013** and this record is true to the best of my knowledge and belief.

Kansas Water Well Contractor's License No. **527** This Water Well Record was completed on (mo/day/yr) **2/10/14** under the business name of **GeoCore, Inc.** by (signature) *Dale Kobl*

INSTRUCTIONS: Use typewriter or ball point pen. PLEASE PRESS FIRMLY and PRINT clearly. Please fill in blanks, underline or circle the correct answers. Send top three copies to Kansas Department of Health and Environment, Bureau of Water, Topeka, Kansas 66620-0001. Telephone: 913-296-5545. Send one to WATER WELL OWNER and retain one for your records.