

**WATER WELL RECORD**

**Form WWC-5**

Division of Water Resources App. No.


20140157

<b>1 LOCATION OF WATER WELL:</b> County: Kiowa	Fraction ¼ SW ¼ NE ¼ NE ¼	Section Number 5	Township No. T 28 S	Range Number R 18 <input type="checkbox"/> E <input checked="" type="checkbox"/> W
---	------------------------------	---------------------	------------------------	---

Street/Rural Address of Well Location; if unknown, distance & direction from nearest town or intersection: If at owner's address, check here .  
1N, 1/2W of Greensburg, KS

**Global Positioning System (GPS) information:**  
 Latitude: ..... (in decimal degrees)  
 Longitude: ..... (in decimal degrees)  
 Elevation: .....  
 Datum:  WGS 84,  NAD 83,  NAD 27  
 Collection Method:  
 GPS unit (Make/Model: .....)  
 Digital Map/Photo,  Topographic Map,  Land Survey  
 Est. Accuracy:  <3 m,  3-5 m,  5-15 m,  >15 m

**2 WATER WELL OWNER:** Dayle Heft  
 RR#, Street Address, Box #: 16482 Highway 183  
 City, State, ZIP Code : Greensburg, KS 67054

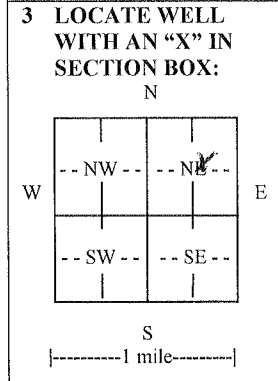

**4 DEPTH OF COMPLETED WELL** .135..... ft.  
 Depth(s) Groundwater Encountered (1).80..... ft. (2)..... ft. (3)..... ft.  
 WELL'S STATIC WATER LEVEL.80.....ft. below land surface measured on mo/day/yr.03/11/14.....  
 Pump test data: Well water was.....ft. after..... hours pumping..... gpm  
 EST. YIELD.80.....gpm. Well water was.....ft. after..... hours pumping..... gpm  
 Bore Hole Diameter .....in. to .....ft., and .....in. to .....ft.  
 WELL WATER TO BE USED AS:  Public water supply  Geothermal  Injection well  
 Domestic  Feedlot  Oil field water supply  Dewatering  Other (Specify below)  
 Irrigation  Industrial  Domestic-lawn & garden  Monitoring well .....  
 Was a chemical/bacteriological sample submitted to Department?  Yes  No  
 If yes, mo/day/yr sample was submitted.....  
 Water well disinfected?  Yes  No

**5 TYPE OF CASING USED:**  Steel  PVC  Other .....  
 CASING JOINTS:  Glued  Clamped  Welded  Threaded  
 Casing diameter .5..... in. to .115..... ft., Diameter ..... in. to ..... ft., Diameter ..... in. to ..... ft.  
 Casing height above land surface .12..... in., Weight 2.8.....lbs./ft., Wall thickness or gauge No. Sch. 40.....  
 TYPE OF SCREEN OR PERFORATION MATERIAL:  
 Steel  Stainless Steel  PVC  Other (Specify) .....  
 Brass  Galvanized Steel  None used (open hole)  
 SCREEN OR PERFORATION OPENINGS ARE:  
 Continuous slot  Mill slot  Gauze wrapped  Torch cut  Drilled holes  None (open hole)  
 Louvered shutter  Key punched  Wire wrapped  Saw cut  Other (specify) .....  
 SCREEN-PERFORATED INTERVALS: From .115..... ft. to .135..... ft., From ..... ft. to ..... ft.  
 From ..... ft. to ..... ft., From ..... ft. to ..... ft.  
 GRAVEL PACK INTERVALS: From .23..... ft. to .135..... ft., From ..... ft. to ..... ft.  
 From ..... ft. to ..... ft., From ..... ft. to ..... ft.

**6 GROUT MATERIAL:**  Neat cement  Cement grout  Bentonite  Other .....  
 Grout Intervals: From 0..... ft. to .23..... ft., From ..... ft. to ..... ft., From ..... ft. to ..... ft.  
 What is the nearest source of possible contamination:  
 Septic tank  Lateral lines  Pit privy  Livestock pens  Insecticide storage  Other (specify below)  
 Sewer lines  Cesspool  Sewage lagoon  Fuel storage  Abandoned water well  
 Watertight sewer lines  Seepage pit  Feedyard  Fertilizer storage  Oil well/gas well .....  
 Direction from well South Southwest..... Distance from well .122.....

FROM	TO	LITHOLOGIC LOG	FROM	TO	LITHO. LOG (cont.) or PLUGGING INTERVALS
0	2	sandy top soil			
2	50	clay			Heft 4-5
50	135	sand and gravel clay bottom			
					Sterling Drilling Company
					P O Box 1006
					Pratt, KS 67124

**7 CONTRACTOR'S OR LANDOWNER'S CERTIFICATION:** This water well was  constructed,  reconstructed, or  plugged under my jurisdiction and was completed on (mo/day/year) 03/11/14..... and this record is true to the best of my knowledge and belief. Kansas Water Well Contractor's License No. 186..... This Water Well Record was completed on (mo/day/year) 03/21/14..... under the business name of Kelly's Water Well Service, Inc..... by (signature) *Kelly's Water Well Service, Inc.*

**INSTRUCTIONS:** Use typewriter or ball point pen. PLEASE PRESS FIRMLY and PRINT clearly. Please fill in blanks and check the correct answers. Send one copy to Kansas Department of Health and Environment, Bureau of Water, Geology Section, 1000 SW Jackson St., Suite 420, Topeka, Kansas 66612-1367. Telephone 785-296-5524. Send one copy to WATER WELL OWNER and retain one for your records. Include fee of \$5.00 for each constructed well. Visit us at <http://www.kdheks.gov/waterwell/index.html>



ASSIGNMENT OF WATER WELL TO LANDOWNER

I, Heft & Sons of 14081 "I" Street  
(Landowner's address)

Greensburg Kansas am the landowner on which a water well is located in  
(City) (State)  
the SW quarter of the NE quarter of the NE quarter in Section 5, Township 28s,  
Range 18 E/W, in Kiowa County, Kansas which is approximately  
4650 feet north/south, and 2055 feet east/west of the apparent SE section  
corner. The water well was drilled in March 2014 (month/year).

I hereby request that Herman L Loeb LLC/Sterling Drilling leave the water well,  
(Operator name)

which was drilled by Temporary Water Permit # 20140157, unplugged, and I will  
assume all responsibility for the plugging of said water well in accordance with the requirements  
of the Kansas Department of Health and Environment regulation K.A.R. 28-30-7.

LANDOWNER:

[Signature] 4-9-14  
(Signature) (Date)

Kevin Heft  
(Print)

OPERATOR:

[Signature] 09/02/14  
(Signature) (Date)

By: **Gary M Talbott/Sterling Drilling**  
(Agent)

IF ADDITIONAL LANDOWNER

\_\_\_\_\_  
(Signature) (Date)

\_\_\_\_\_  
(Print)

RECEIVED  
APR 15 2014  
BUREAU OF WATER