

MW102

WATER WELL RECORD

Form WWC-5


Division of Water Resources App. No.

1 LOCATION OF WATER WELL: County: Kiowa, Fraction 1/4 NW 1/4 SW 1/4, Section Number 17, Township No. T 28 S, Range Number R 18 E W

Street/Rural Address of Well Location; if unknown, distance & direction from nearest town or intersection: 15240 183 Hwy Greensburg, KS 67054

Global Positioning System (GPS) information: Latitude: 37.608223, Longitude: -99.317429, Elevation: 2248

2 WATER WELL OWNER: ADM-Grain, RR#, Street Address, Box #: 15240 183 Hwy, City, State, ZIP Code: Citv. State. ZIP Code

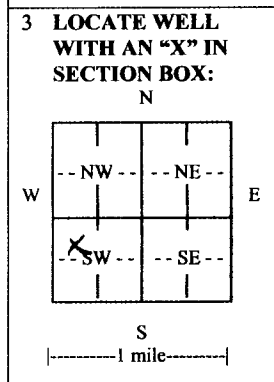

3 LOCATE WELL WITH AN 'X' IN SECTION BOX: 4 DEPTH OF COMPLETED WELL 90 ft. Depth(s) Groundwater Encountered (1).78 ft. (2)..... ft. (3)..... ft. WELL'S STATIC WATER LEVEL 78 ft. below land surface measured on mo/day/yr. 07/15/14

5 TYPE OF CASING USED: Steel PVC Other, CASING JOINTS: Glued Clamped Welded Threaded, Casing diameter 2 in. to 90 ft., Diameter in. to ft., Diameter in. to ft., Casing height above land surface 6 in., Weight lbs./ft., Wall thickness or gauge No.

6 GROUT MATERIAL: Neat cement Cement grout Bentonite Other Bentonite aroud, Grout Intervals: From 66 ft. to 62 ft., From 62 ft. to 4 ft., From 4 ft. to 1 ft.

Table with columns: FROM, TO, LITHOLOGIC LOG, FROM, TO, LITHO. LOG (cont.) or PLUGGING INTERVALS. Rows show depth intervals from 0 to 90 feet with descriptions like 'sandy clay/clayey sand, brown, soft'.

7 CONTRACTOR'S OR LANDOWNER'S CERTIFICATION: This water well was constructed, reconstructed, or plugged under my jurisdiction and was completed on (mo/day/year) 7/15/14

INSTRUCTIONS: Use typewriter or ball point pen. PLEASE PRESS FIRMLY and PRINT clearly. Please fill in blanks and check the correct answers. Send one copy to Kansas Department of Health and Environment, Bureau of Water, Geology Section, 1000 SW Jackson St., Suite 420, Topeka, Kansas 66612-1367.