


1 LOCATION OF WATER WELL: Fraction CS1/2 1/4 S1/2 1/4 NW 1/4 Section Number 6 Township Number T 28 S Range Number R 18 W EW
 County: Kiowa

Distance and direction from nearest town or city street address of well if located within city?
 2.75N .75W 3/8S of C/Int. of 54 and 183 highways at Greensburg, Kansas

2 WATER WELL OWNER: Abercrombie Drilling Co.
 RR#, St. Address, Box # : Box 56 Board of Agriculture, Division of Water Resources
 City, State, ZIP Code : Great Bend, Kansas 67530 Calglasier #4 Application Number:

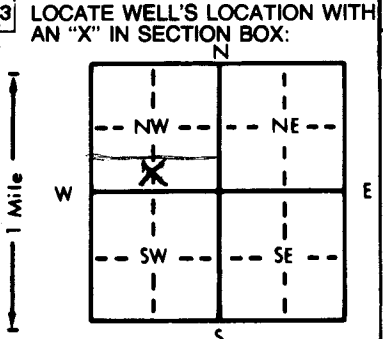

4 DEPTH OF COMPLETED WELL... 100 ft. ELEVATION:
 Depth(s) Groundwater Encountered 1. 67 ft. 2. ft. 3. ft.
 WELL'S STATIC WATER LEVEL ... 67 ft. below land surface measured on mo/day/yr ... 26 July 85
 Pump test data: Well water was ... ft. after ... hours pumping ... gpm
 Est. Yield ... 80 gpm: Well water was ... ft. after ... hours pumping ... gpm
 Bore Hole Diameter ... 10 in. to ... 100 ft., and ... in. to ... ft.
 WELL WATER TO BE USED AS: 5 Public water supply 8 Air conditioning 11 Injection well
 1 Domestic 3 Feedlot XX 6 Oil field water supply 9 Dewatering 12 Other (Specify below)
 2 Irrigation 4 Industrial 7 Lawn and garden only 10 Observation well
 Was a chemical/bacteriological sample submitted to Department? Yes.....No...X.....; If yes, mo/day/yr sample was submitted
 Water Well Disinfected? Yes X No

5 TYPE OF BLANK CASING USED: 5 Wrought iron 8 Concrete tile CASING JOINTS: Glued X Clamped
 1 Steel 3 RMP (SR) 6 Asbestos-Cement 9 Other (specify below) Welded
XX 2 PVC 4 ABS 7 Fiberglass Threaded
 Blank casing diameter ... 5 in. to ~~XX 80~~ 80 ft., Dia ... in. to ... ft., Dia ... in. to ... ft.
 Casing height above land surface ... 12 in., weight ... 2.34 lbs./ft. Wall thickness or gauge No. ... 2.14
 TYPE OF SCREEN OR PERFORATION MATERIAL: XX 7 PVC 10 Asbestos-cement
 1 Steel 3 Stainless steel 5 Fiberglass 8 RMP (SR) 11 Other (specify)
 2 Brass 4 Galvanized steel 6 Concrete tile 9 ABS 12 None used (open hole)
 SCREEN OR PERFORATION OPENINGS ARE: 5 Gauzed wrapped XX 8 Saw cut 11 None (open hole)
 1 Continuous slot 3 Mill slot 6 Wire wrapped 9 Drilled holes
 2 Louvered shutter 4 Key punched 7 Torch cut 10 Other (specify)
 SCREEN-PERFORATED INTERVALS: From ... 80 ft. to ... 100 ft., From ... ft. to ... ft.
 From ... ft. to ... ft., From ... ft. to ... ft.
 GRAVEL PACK INTERVALS: From ... 10 ft. to ... 100 ft., From ... ft. to ... ft.
 From ... ft. to ... ft., From ... ft. to ... ft.

6 GROUT MATERIAL: 1 Neat cement XX 2 Cement grout 3 Bentonite 4 Other
 Grout intervals: From ... 0 ft. to ... 10 ft., From ... ft. to ... ft., From ... ft. to ... ft.
 What is the nearest source of possible contamination:
 1 Septic tank 4 Lateral lines 7 Pit privy 10 Livestock pens 14 Abandoned water well
 2 Sewer lines 5 Cess pool 8 Sewage lagoon 11 Fuel storage 15 Oil well/Gas well
 3 Watertight sewer lines 6 Seepage pit 9 Feedyard 12 Fertilizer storage 16 Other (specify below)
 13 Insecticide storage none
 Direction from well? How many feet?

FROM	TO	LITHOLOGIC LOG	FROM	TO	LITHOLOGIC LOG
0	2	Silt, sandy			
2	22	Sand, fine			
22	34	Clay, tan			
34	60	Sand, coarse and very coarse gravel			
60	64	Clay, tan and white			
64	100	Sand, fine to coarse and fine to coarse gravel			

7 CONTRACTOR'S OR LANDOWNER'S CERTIFICATION: This water well was (1) constructed, (2) reconstructed, or (3) plugged under my jurisdiction and was completed on (mo/day/year) ... 26 July 85 ... and this record is true to the best of my knowledge and belief. Kansas Water Well Contractor's License No. ... 325 ... This Water Well Record was completed on (mo/day/yr) ... 2 Sept. 85 ... under the business name of Central Well and Pump by (signature) Abercrombie
 INSTRUCTIONS: Use typewriter or ball point pen. PLEASE PRESS FIRMLY and PRINT clearly. Please fill in blanks, underline or circle the correct answers. Send top three copies to Kansas Department of Health and Environment, Office of Oil Field and Environmental Geology, Regulation and Permitting Section, Topeka, Kansas 66620-7500, Telephone: 913-862-9360. Send one to WATER WELL OWNER and retain one for your records.

OFFICE USE ONLY
T
R
EW
SEC.
1/4
1/4
1/4