


1 LOCATION OF WATER WELL: County: Kiowa Fraction: NW 1/4 NW 1/4 NW 1/4 Section Number: 27 Township Number: T 28 S Range Number: R 18 E/W

Distance and direction from nearest town or city street address of well if located within city? 1.5 of S.E. corner of Greensburg Kans

2 WATER WELL OWNER: Mable Witt Board of Agriculture, Division of Water Resources  
RR#, St. Address, Box #: Greensburg Kans Application Number:

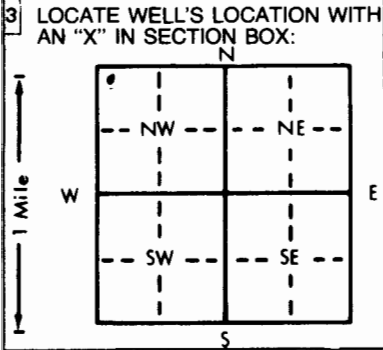

4 DEPTH OF COMPLETED WELL: 140 ft. ELEVATION: ..... ft.  
Depth(s) Groundwater Encountered 1. 96 ft. 2. .... ft. 3. .... ft.  
WELL'S STATIC WATER LEVEL: 96 ft. below land surface measured on 6-16-86  
Pump test data: Well water was 96 ft. after 1 hours pumping 3 gpm  
Est. Yield 20 gpm. Well water was ..... ft. after ..... hours pumping ..... gpm  
Bore Hole Diameter: 8 3/4 in. to 140 ft., and ..... in. to ..... ft.  
WELL WATER TO BE USED AS:  
 1 Domestic     3 Feedlot     6 Oil field water supply     9 Dewatering     12 Other (Specify below)  
 2 Irrigation     4 Industrial     7 Lawn and garden only     10 Observation well  
Was a chemical/bacteriological sample submitted to Department? Yes.....No.....; If yes, mo/day/yr sample was submitted  
Water Well Disinfected? Yes  No

5 TYPE OF BLANK CASING USED:  
1 Steel     3 AMP (SR)    5 Wrought iron    8 Concrete tile    CASING JOINTS: Glued  Clamped .....  
2 PVC    4 ABS    6 Asbestos-Cement    9 Other (specify below)    Welded .....  
Blank casing diameter 5 in. to 120 ft., Dia ..... in. to ..... ft., Dia ..... in. to ..... ft.  
Casing height above land surface 24 in., weight ..... lbs./ft. Wall thickness or gauge No. SDR-26

TYPE OF SCREEN OR PERFORATION MATERIAL:  
1 Steel    3 Stainless steel    5 Fiberglass     8 AMP (SR)    10 Asbestos-cement    11 Other (specify) .....  
2 Brass    4 Galvanized steel    6 Concrete tile    9 ABS    12 None used (open hole)

SCREEN OR PERFORATION OPENINGS ARE:  
1 Continuous slot    3 Mill slot    5 Gauzed wrapped     8 Saw cut    11 None (open hole)  
2 Louvered shutter    4 Key punched    6 Wire wrapped    9 Drilled holes  
3 Torch cut    10 Other (specify) .....

SCREEN-PERFORATED INTERVALS: From 120 ft. to 140 ft., From ..... ft. to ..... ft.  
From ..... ft. to ..... ft., From ..... ft. to ..... ft.  
GRAVEL PACK INTERVALS: From 100 ft. to 140 ft., From ..... ft. to ..... ft.  
From ..... ft. to ..... ft., From ..... ft. to ..... ft.

6 GROUT MATERIAL:  1 Neat cement    2 Cement grout    3 Bentonite    4 Other .....  
Grout Intervals: From 0 ft. to 10 ft., From ..... ft. to ..... ft., From ..... ft. to ..... ft.

What is the nearest source of possible contamination:  
1 Septic tank    4 Lateral lines    7 Pit privy     10 Livestock pens    14 Abandoned water well  
2 Sewer lines    5 Cess pool    8 Sewage lagoon    11 Fuel storage    15 Oil well/Gas well  
3 Watertight sewer lines    6 Seepage pit    9 Feedyard    12 Fertilizer storage    16 Other (specify below)  
13 Insecticide storage .....  
Direction from well? NE How many feet? 150

| FROM | TO  | LITHOLOGIC LOG           | FROM | TO | LITHOLOGIC LOG |
|------|-----|--------------------------|------|----|----------------|
| 0    | 3   | Top Soil                 |      |    |                |
| 3    | 74  | Tan Clay                 |      |    |                |
| 74   | 104 | GRAVEL                   |      |    |                |
| 104  | 120 | Tan Clay                 |      |    |                |
| 120  | 140 | Gravel with Clay streaks |      |    |                |

7 CONTRACTOR'S OR LANDOWNER'S CERTIFICATION: This water well was  (1) constructed, (2) reconstructed, or (3) plugged under my jurisdiction and was completed on (mo/day/year) 6-16-86 and this record is true to the best of my knowledge and belief. Kansas Water Well Contractor's License No. 224 This Water Well Record was completed on (mo/day/yr) 6-24-86 under the business name of Carl Hays Water Well Serv. by (signature) Carl Hays  
INSTRUCTIONS: Use typewriter or ball point pen, PLEASE PRESS FIRMLY and PRINT clearly. Please fill in blanks, underline or circle the correct answers. Send top three copies to Kansas Department of Health and Environment, Division of Environment, Environmental Geology Section, Topeka, KS 66620. Send one to WATER WELL OWNER and retain one for your records.

OFFICE USE ONLY  
T  
R  
EW  
SEC.  
1/4  
1/4  
1/4