


422

WATER WELL RECORD Form WWC-5 KSA 82a-1212

1 LOCATION OF WATER WELL: Fraction Section Number Township Number Range Number  
 COUNTY: KIOWA SW 1/4 NE 1/4 NW 1/4 5 T 28 S R 18 W

Distance and direction from nearest town or city street address of well if located within city?  
 1 MILE WEST, 2.5 MILES NORTH OF GREENSBURG

2 WATER WELL OWNER: TGT PETROLEUM CORPORATION  
 RR#, St. Address, Box # : PO BOX 75097 Board of Agriculture, Division of Water Resources  
 City, State, ZIP code : WICHITA, KS 67275-0097 Application Number: 20140902

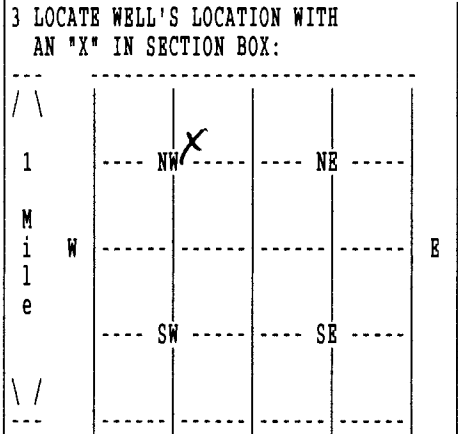

4 DEPTH OF COMPLETED WELL 155 ELEVATION: 0  
 Depth(s) Groundwater Encountered 1. 0 ft. 2. 0 ft. 3. 0 ft.  
 WELL'S STATIC WATER LEVEL 69 ft. below land surface measured on mo/day/yr 11/01/14  
 Pump test data: Well water was 0 ft. after 0 hours pumping 0 gpm  
 Estimated Yield 0 gpm: Well water was 0 ft. after 0 hours pumping 0 gpm  
 Bore Hole Diameter 8.75 in. to 155 ft., and in. to 0 ft.  
 WELL WATER TO BE USED AS: OIL FIELD  
 Was a chemical/bacteriological sample submitted to department? No ;  
 If yes, mo/day/yr sample was submitted Water well disinfected? Yes

5 TYPE OF BLANK CASING USED: PVC CASING JOINTS: GLUED  
 Blank casing diameter 5 in. to 135 ft., Dia in. to 0 ft., Dia in. to 0 ft.  
 Casing height above land surface 18 in., weight 0 lbs/ft. Wall thickness or gauge No. 26  
 TYPE OF SCREEN OR PERFORATION MATERIAL: PVC  
 SCREEN OR PERFORATION OPENINGS ARE: SAW CUT

SCREEN PERFORATED INTERVALS: From 135 ft. to 155 ft., From 0 ft. to 0 ft.  
 From 0 ft. to 0 ft., From 0 ft. to 0 ft.  
 GRAVEL PACK INTERVALS: From 25 ft. to 155 ft., From 0 ft. to 0 ft.  
 From 0 ft. to 0 ft., From 0 ft. to 0 ft.

6 GROUT MATERIAL BENTONITE  
 Grout intervals: From 0 ft. to 25 ft., From 0 ft. to 0 ft., From 0 ft. to 0 ft.  
 What is the nearest source of possible contamination: OIL/GAS WELL  
 Direction from well? SOUTH How many feet? 2500

FROM	TO	LITHOLOGIC LOG	FROM	TO	PLUGGING INTERVALS
0	9	SILT AND SAND			
9	40	TAN CLAY			
40	155	SAND AND GRAVEL			

7 CONTRACTOR'S OR LANDOWNER'S CERTIFICATION: This water well was Constructed under my jurisdiction and was completed on (mo/day/year) 11/01/14 and this record is true to the best of my knowledge and belief. Kansas Water Well Contractor's License No. 653 This Water Well Record was completed on (mo/day/yr) 12/04/14 under the business name of DAN HAYSE WATER WELL SERV by (signature) Dan Hayse