


1 LOCATION OF WATER WELL: Fraction Section Number Township Number Range Number
County: Kiowa SW 1/4 NE 1/4 SW 1/4 16 T 28 S R 18 EW

Distance and direction from nearest town or city street address of well if located within city?
419 W. Kansas, Greensburg, KS

2 WATER WELL OWNER: Coastal Mart #2509
RR#, St. Address, Box #: 419 W. Kansas
City, State, ZIP Code: Greensburg, Kansas 67054
Board of Agriculture, Division of Water Resources
Application Number:

3 LOCATE WELL'S LOCATION WITH AN 'X' IN SECTION BOX:
4 DEPTH OF COMPLETED WELL: 100 ft. ELEVATION:
Depth(s) Groundwater Encountered: 1. 85 ft. 2. ft. 3. ft.

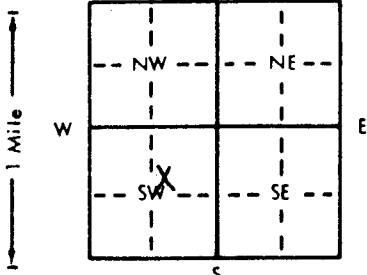

WELL'S STATIC WATER LEVEL: 86.84 ft. below measured on 08-03-94
Pump test data: Well water was ft. after hours pumping gpm
Est. Yield gpm: Well water was ft. after hours pumping gpm
Bore Hole Diameter: 7 5/8 in. to 100 ft. and in. to ft.
WELL WATER TO BE USED AS: 5 Public water supply 8 Air conditioning 11 Injection well
1 Domestic 3 Feedlot 6 Oil field water supply 9 Dewatering 12 Other (Specify below)
2 Irrigation 4 Industrial 7 Lawn and garden only 10 Monitoring well
Was a chemical/bacteriological sample submitted to Department? Yes No X; If yes, mo/day/yr sample was submitted

5 TYPE OF BLANK CASING USED: 1 Steel 2 PVC 3 RMP (SR) 4 ABS 5 Wrought iron 6 Asbestos-Cement 7 Fiberglass 8 Concrete tile 9 Other (specify below) CASING JOINTS: Glued Clamped Welded Threaded X

Blank casing diameter: 2 in. to 75 ft. Dia in. to ft. Dia in. to ft.
Casing height above land surface: 0 in., weight lbs./ft. Wall thickness or gauge No. sch. 40

TYPE OF SCREEN OR PERFORATION MATERIAL: 1 Steel 2 Brass 3 Stainless steel 4 Galvanized steel 5 Fiberglass 6 Concrete tile 7 PVC 8 RMP (SR) 9 ABS 10 Asbestos-cement 11 Other (specify) 12 None used (open hole)

SCREEN OR PERFORATION OPENINGS ARE: 1 Continuous slot 2 Louvered shutter 3 Mill slot 4 Key punched 5 Gauzed wrapped 6 Wire wrapped 7 Torch cut 8 Saw cut 9 Drilled holes 11 None (open hole) 10 Other (specify)

SCREEN-PERFORATED INTERVALS: From 75 ft. to 100 ft. From ft. to ft. From ft. to ft.
GRAVEL PACK INTERVALS: From 73 ft. to 100 ft. From ft. to ft. From ft. to ft.

6 GROUT MATERIAL: 1 Neat cement 2 Cement grout 3 Bentonite 4 Other
Grout Intervals: From 0 ft. to 70.9 ft. From 70.9 ft. to 73 ft. From ft. to ft.

What is the nearest source of possible contamination: 1 Septic tank 2 Sewer lines 3 Watertight sewer lines 4 Lateral lines 5 Cess pool 6 Seepage pit 7 Pit privy 8 Sewage lagoon 9 Feedyard 10 Livestock pens 11 Fuel storage 12 Fertilizer storage 13 Insecticide storage 14 Abandoned water well 15 Oil well/Gas well 16 Other (specify below)

Direction from well? Southwest How many feet? 50

Table with columns: FROM, TO, LITHOLOGIC LOG, FROM, TO, PLUGGING INTERVALS. Rows show depth intervals and lithology: 0-0.3 Asphalt, 0.3-17 Clay, mod-dk brn, mod-v slty, tr snd, soft damp, 17-30 Sand, lt brn, f-m, sl tr slit, w srtd, damp, 30-56 Sand, mod-lt brn, v f-f sl tr slit, w srtd, damp, 56-65 Clay, lt brn/mott grn, v sndy, mod stiff sl plst, moist, 65-100 Sand, v lt brn, f-c w/mod f-m grvl, p srtd, damp.

MW3 - Flushmount
ID # 00101330
Don Taylor

7 CONTRACTOR'S OR LANDOWNER'S CERTIFICATION: This water well was constructed, reconstructed, or plugged under my jurisdiction and was completed on 07-28-94 and this record is true to the best of my knowledge and belief. Kansas Water Well Contractor's License No. 527 This Water Well Record was completed on 08-05-94 under the business name of GeoCore Services, Inc. by (signature)