

**WATER WELL RECORD Form WWC-5 KSA 82a-1212**


1 LOCATION OF WATER WELL:	Fraction	Section Number	Township Number	Range Number
County: <u>kiowa</u>	<u>SE</u> ¼ <u>NE</u> ¼ <u>SW</u> ¼	<u>16</u>	<u>T 28 S</u>	<u>R 18 E</u> <span style="border: 1px solid black; border-radius: 50%; padding: 2px;">W</span>

Distance and direction from nearest town or city street address of well if located within city?

419 W. Kansas, Greensburg, KS

2 WATER WELL OWNER: <u>Coastal Mart #2509</u>	Board of Agriculture, Division of Water Resources Application Number:
RR#, St. Address, Box # : <u>419 W. Kansas</u>	
City, State, ZIP Code : <u>Greensburg, Kansas 67054</u>	

3 LOCATE WELL'S LOCATION WITH AN "X" IN SECTION BOX:

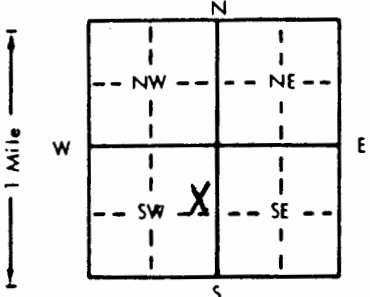

4 DEPTH OF COMPLETED WELL: 100 ft. ELEVATION:

Depth(s) Groundwater Encountered 1. 85 ft. 2. \_\_\_\_\_ ft. 3. \_\_\_\_\_ ft.

WELL'S STATIC WATER LEVEL 83.04 ft. below \_\_\_\_\_ measured on mo/day/yr 83.94

Pump test data: Well water was \_\_\_\_\_ ft. after \_\_\_\_\_ hours pumping \_\_\_\_\_ gpm

Est. Yield \_\_\_\_\_ gpm: Well water was \_\_\_\_\_ ft. after \_\_\_\_\_ hours pumping \_\_\_\_\_ gpm

Bore Hole Diameter 7.5/8 in. to 105 ft., and \_\_\_\_\_ in. to \_\_\_\_\_ ft.

WELL WATER TO BE USED AS:

1 Domestic	3 Feedlot	6 Oil field water supply	8 Air conditioning	11 Injection well
2 Irrigation	4 Industrial	7 Lawn and garden only	9 Dewatering	12 Other (Specify below)

Monitoring well  10

Was a chemical/bacteriological sample submitted to Department? Yes \_\_\_\_\_ No  X

If yes, mo/day/yr sample was submitted \_\_\_\_\_

Water Well Disinfected? Yes \_\_\_\_\_ No  X

5 TYPE OF BLANK CASING USED:

1 Steel	3 RMP (SR)	5 Wrought iron	8 Concrete tile	CASING JOINTS: Glued _____ Clamped _____
<input checked="" type="checkbox"/> 2 PVC	4 ABS	6 Asbestos-Cement	9 Other (specify below)	Welded _____
		7 Fiberglass		Threaded <input checked="" type="checkbox"/> X

Blank casing diameter 2 in. to 75 ft., Dia \_\_\_\_\_ in. to \_\_\_\_\_ ft., Dia \_\_\_\_\_ in. to \_\_\_\_\_ ft.

Casing height above land surface 0 in., weight \_\_\_\_\_ lbs./ft. Wall thickness or gauge No. Sch. 40

TYPE OF SCREEN OR PERFORATION MATERIAL:

1 Steel	3 Stainless steel	5 Fiberglass	<input checked="" type="checkbox"/> 7 PVC	10 Asbestos-cement
2 Brass	4 Galvanized steel	6 Concrete tile	8 RMP (SR)	11 Other (specify) _____
			9 ABS	12 None used (open hole)

SCREEN OR PERFORATION OPENINGS ARE:

1 Continuous slot	<input checked="" type="checkbox"/> 3 Mill slot	5 Gauzed wrapped	8 Saw cut	11 None (open hole)
2 Louvered shutter	4 Key punched	6 Wire wrapped	9 Drilled holes	
		7 Torch cut	10 Other (specify) _____	

SCREEN-PERFORATED INTERVALS: From 75 ft. to 100 ft., From \_\_\_\_\_ ft. to \_\_\_\_\_ ft.

GRAVEL PACK INTERVALS: From 71.5 ft. to 100 ft., From \_\_\_\_\_ ft. to \_\_\_\_\_ ft.

6 GROUT MATERIAL: 1 Neat cement  2 Cement grout  3 Bentonite  4 Other \_\_\_\_\_

Grout Intervals: From 0 ft. to 69 ft., From 69 ft. to 71.5 ft., From \_\_\_\_\_ ft. to \_\_\_\_\_ ft.

What is the nearest source of possible contamination:

1 Septic tank	4 Lateral lines	7 Pit privy	<input checked="" type="checkbox"/> 11 Fuel storage	14 Abandoned water well
2 Sewer lines	5 Cess pool	8 Sewage lagoon	12 Fertilizer storage	15 Oil well/Gas well
3 Watertight sewer lines	6 Seepage pit	9 Feedyard	13 Insecticide storage	16 Other (specify below)

Direction from well? West How many feet? 275

FROM	TO	LITHOLOGIC LOG	FROM	TO	PLUGGING INTERVALS
0	4	Clay, dk-mod brn, sl slty, firm, med plst damp			
4	20	Clay, mod brn, sl slty, sl sndy, firm 1 plst, damp			
20	50	Sand, lt brn, v f-f, tr-mod slt, mod-w srted, damp			
50	60	Sand, v lt brn, f gn, sl tr slt, w srted, damp			
60	75	Sand, lt brn, f-v c, mod slty, p srted moist			
75	100	Sand, v lt grn/brn, f-v c w/ mod f-m grvl, p srted, damp			
					M7 - Flushmount ID # 00103879 Don Taylor

7 CONTRACTOR'S OR LANDOWNER'S CERTIFICATION: This water well was  (1) constructed, (2) reconstructed, or (3) plugged under my jurisdiction and was completed on (mo/day/year) 07-28-94 and this record is true to the best of my knowledge and belief. Kansas Water Well Contractor's License No. 527 This Water Well Record was completed on (mo/day/yr) 08-05-94 under the business name of GeoCore Services, Inc. by (signature) Don Taylor

INSTRUCTIONS: Use typewriter or ball point pen. PLEASE PRESS FIRMLY and PRINT clearly. Please fill in blanks, underline or circle the correct answers. Send top three copies to Kansas Department of Health and Environment, Bureau of Water, Topeka, Kansas 66620-0001. Telephone: 913-296-5545. Send one to WATER WELL OWNER and retain one for your records.