

WATER WELL RECORD Form WWC-5 KSA 82a-1212


1 LOCATION OF WATER WELL: County: kiowa Fraction SF 1/4 NE 1/4 SW 1/4 Section Number 16 Township Number T 28 S Range Number R 18 E/W

Distance and direction from nearest town or city street address of well if located within city?

419 W. Kansas, Greensburg, KS

2 WATER WELL OWNER: Coastal Mart #2509 Board of Agriculture, Division of Water Resources
 RR#, St. Address, Box #: 419 W. Kansas Application Number:
 City, State, ZIP Code: Greensburg, Kansas 67054

3 LOCATE WELL'S LOCATION WITH AN "X" IN SECTION BOX:

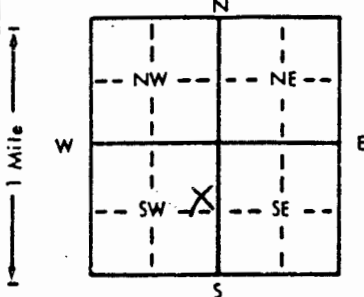

4 DEPTH OF COMPLETED WELL: 90 ft. ELEVATION:
 Depth(s) Groundwater Encountered 1. 75 ft. 2. 74.20 ft. 3. 20 ft.
 WELL'S STATIC WATER LEVEL 74.20 ft. below 74.20 measured on mo/day/yr
 Pump test data: Well water was 75 ft. after 74.20 hours pumping 20 gpm
 Est. Yield 20 gpm: Well water was 75 ft. after 74.20 hours pumping 20 gpm
 Bore Hole Diameter 7.5/8 in. to 90 ft., and 90 in. to 90 ft.
 WELL WATER TO BE USED AS: 5 Public water supply 8 Air conditioning 11 Injection well
 1 Domestic 3 Feedlot 6 Oil field water supply 9 Dewatering 12 Other (Specify below)
 2 Irrigation 4 Industrial 7 Lawn and garden only 10 Monitoring well
 Was a chemical/bacteriological sample submitted to Department? Yes X No X; If yes, mo/day/yr sample was submitted
 Water Well Disinfected? Yes X No X

5 TYPE OF BLANK CASING USED: 1 Steel 3 RMP (SR) 5 Wrought iron 8 Concrete tile CASING JOINTS: Glued Clamped
2 PVC 4 ABS 7 Fiberglass 9 Other (specify below) Welded
 Blank casing diameter 2 in. to 65 ft., Dia in. to ft., Dia in. to ft.
 Casing height above land surface 0 in., weight lbs./ft. Wall thickness or gauge No. Sch. 40
 TYPE OF SCREEN OR PERFORATION MATERIAL: 7 PVC 10 Asbestos-cement
 1 Steel 3 Stainless steel 5 Fiberglass 8 RMP (SR) 11 Other (specify)
 2 Brass 4 Galvanized steel 6 Concrete tile 9 ABS 12 None used (open hole)

SCREEN OR PERFORATION OPENINGS ARE: 5 Gauzed wrapped 8 Saw cut 11 None (open hole)
 1 Continuous slot 3 Mill slot 6 Wire wrapped 9 Drilled holes
 2 Louvered shutter 4 Key punched 7 Torch cut 10 Other (specify)

SCREEN-PERFORATED INTERVALS: From 65 ft. to 90 ft., From ft. to ft.
 From ft. to ft., From ft. to ft.

GRAVEL PACK INTERVALS: From 62.5 ft. to 90 ft., From ft. to ft.
 From ft. to ft., From ft. to ft.

6 GROUT MATERIAL: 1 Neat cement 2 Cement grout 3 Bentonite 4 Other
 Grout Intervals: From 0 ft. to 60 ft., From 60 ft. to 62.5 ft., From ft. to ft.
 What is the nearest source of possible contamination: 10 Livestock pens 14 Abandoned water well
 1 Septic tank 4 Lateral lines 7 Pit privy 11 Fuel storage 15 Oil well/Gas well
 2 Sewer lines 5 Cess pool 8 Sewage lagoon 12 Fertilizer storage 16 Other (specify below)
 3 Watertight sewer lines 6 Seepage pit 9 Feedyard 13 Insecticide storage
 Direction from well? Southwest How many feet? 650

FROM	TO	LITHOLOGIC LOG	FROM	TO	PLUGGING INTERVALS
0	2	Clay, dk brn, sl slty, soft, low plst, dry			
2	10	Clay, mod brn, sl slty, firm, med plst, damp			
10	35	Clay, mod brn, stiff, med plst, tr calic, damp			
35	50	SAnd, lt or/brn, v f-f, sl-mod slty, mod srted, damp			
50	60	Clay, lt gy/brn, stiff, med plst, mod sndy, damp			
60	90	Sand, rst-lt brn, f-v c w/ sl-mod f-m grvl, p srted, damp			

MW17 - Flushmount
 ID # 00103480
 Don Taylor

7 CONTRACTOR'S OR LANDOWNER'S CERTIFICATION: This water well was 1 constructed, (2) reconstructed, or (3) plugged under my jurisdiction and was completed on (mo/day/year) 07-28-94 and this record is true to the best of my knowledge and belief. Kansas Water Well Contractor's License No. 527 This Water Well Record was completed on (mo/day/yr) 08-05-94 under the business name of GeoCore Services, Inc. by (signature) Don Taylor

INSTRUCTIONS: Use typewriter or ball point pen. PLEASE PRESS FIRMLY and PRINT clearly. Please fill in blanks, underline or circle the correct answers. Send top three copies to Kansas Department of Health and Environment, Bureau of Water, Topeka, Kansas 66620-0001. Telephone: 913-298-5545. Send one to WATER WELL OWNER and retain one for your records.