


1 LOCATION OF WATER WELL: County: Kiowa Fraction: SW 1/4 SW 1/4 NW 1/4 Section Number: 14 Township Number: T 28 S Range Number: R 19 E/W

Distance and direction from nearest town or city street address of well if located within city? 5 W. GREENSBURG Kansas

2 WATER WELL OWNER: Dennis Faulk Board of Agriculture, Division of Water Resources
 RR#, St. Address, Box #: (GREENSBURG Kans) Application Number:

3 LOCATE WELL'S LOCATION WITH AN "X" IN SECTION BOX:

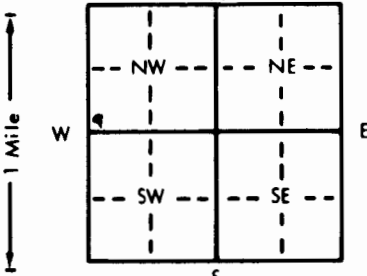

4 DEPTH OF COMPLETED WELL: 80 ft. ELEVATION: 53 ft.

 WELL'S STATIC WATER LEVEL 53 ft. below land surface measured on mo/day/yr 1-3-84
 Pump test data: Well water was 53 ft. after 1 hours pumping 4 gpm
 Est. Yield 15 gpm: Well water was 53 ft. after 1 hours pumping 4 gpm
 Bore Hole Diameter: 8 3/4 in. to 80 ft., and 80 in. to 80 ft.
 WELL WATER TO BE USED AS:
 1 Domestic 2 Irrigation 3 Feedlot 4 Industrial
 5 Public water supply 6 Oil field water supply 7 Lawn and garden only
 8 Air conditioning 9 Dewatering 10 Observation well
 11 Injection well 12 Other (Specify below)
 Was a chemical/bacteriological sample submitted to Department? Yes X No X; If yes, mo/day/yr sample was submitted
 Water Well Disinfected? Yes X No X

5 TYPE OF BLANK CASING USED:
 1 Steel 3 RMP (SR) 5 Wrought iron 8 Concrete tile CASING JOINTS: Glued X Clamped
 2 PVC 4 ABS 6 Asbestos-Cement 9 Other (specify below) Welded
 7 Fiberglass Threaded
 Casing height above land surface 18 in., weight 18 lbs./ft. Wall thickness or gauge No. SDR-26

TYPE OF SCREEN OR PERFORATION MATERIAL:
 1 Steel 3 Stainless steel 5 Fiberglass 6 RMP (SR) 10 Asbestos-cement
 2 Brass 4 Galvanized steel 6 Concrete tile 9 ABS 11 Other (specify)
 12 None used (open hole)

SCREEN OR PERFORATION OPENINGS ARE:
 1 Continuous slot 3 Mill slot 5 Gauzed wrapped 8 Saw cut 11 None (open hole)
 2 Louvered shutter 4 Key punched 6 Wire wrapped 9 Drilled holes
 7 Torch cut 10 Other (specify)



What is the nearest source of possible contamination:
 1 Septic tank 4 Lateral lines 7 Pit privy 10 Livestock pens 14 Abandoned water well
 2 Sewer lines 5 Cess pool 8 Sewage lagoon 11 Fuel storage 15 Oil well/Gas well
 3 Watertight sewer lines 6 Seepage pit 9 Feedyard 12 Fertilizer storage 16 Other (specify below) PASTURE
 13 Insecticide storage

Direction from well? _____ How many feet? _____

FROM	TO	LITHOLOGIC LOG	FROM	TO	LITHOLOGIC LOG
0	1	TOP SOIL			
1	14	Sandy Clay			
14	16	Gravel			
16	32	Clay & Gyp			
32	80	Gravel			

7 CONTRACTOR'S OR LANDOWNER'S CERTIFICATION: This water well was (1) constructed, (2) reconstructed, or (3) plugged under my jurisdiction and was completed on (mo/day/year) 1-3-84 and this record is true to the best of my knowledge and belief. Kansas Water Well Contractor's License No. 234 This Water Well Record was completed on (mo/day/yr) 7-31-84 under the business name of Carl Hays Water Well Serv. by (signature) Carl Hays

INSTRUCTIONS: Use typewriter or ball point pen. PLEASE PRESS FIRMLY and PRINT clearly. Please fill in blanks, underline or circle the correct answers. Send top three copies to Kansas Department of Health and Environment, Division of Environment, Environmental Geology Section, Topeka, KS 66620. Send one to WATER WELL OWNER and retain one for your records.

OFFICE USE ONLY
T
R
EW
SEC.
1/4
1/4
1/4