


1 LOCATION OF WATER WELL: County: kiowa Fraction: SE 1/4 SE 1/4 NW 1/4 Section Number: 14 Township Number: T 28 S Range Number: R 19 E/W

Distance and direction from nearest town or city street address of well if located within city?
4 W Greensburg Kansas

2 WATER WELL OWNER: Dennis Pauly
RR#, St. Address, Box #: Greensburg Kans
City, State, ZIP Code: Greensburg Kansas
Board of Agriculture, Division of Water Resources Application Number:

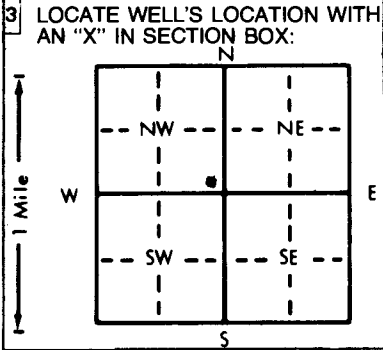

4 DEPTH OF COMPLETED WELL: 82 ft. ELEVATION: _____
Depth(s) Groundwater Encountered 1. 3.7 ft. 2. _____ ft. 3. _____ ft.
WELL'S STATIC WATER LEVEL: 3.7 ft. below land surface measured on mo/day/yr 9-6-79
Pump test data: Well water was 37 ft. after _____ hours pumping _____ gpm
Est. Yield 2.0 gpm: Well water was _____ ft. after _____ hours pumping _____ gpm
Bore Hole Diameter: 8 3/4 in. to 8 2 ft., and _____ in. to _____ ft.
WELL WATER TO BE USED AS:
5 Public water supply 8 Air conditioning 11 Injection well
1 Domestic 3 Feedlot 6 Oil field water supply 9 Dewatering 12 Other (Specify below)
2 Irrigation 4 Industrial 7 Lawn and garden only 10 Observation well PASTURE
Was a chemical/bacteriological sample submitted to Department? Yes _____ No X; If yes, mo/day/yr sample was submitted _____
Water Well Disinfected? Yes X No _____

5 TYPE OF BLANK CASING USED:
1 Steel 2 PVC 3 RMP (SR) 4 ABS 5 Wrought iron 6 Asbestos-Cement 7 Fiberglass 8 Concrete tile 9 Other (specify below) 10 Asbestos-cement 11 Other (specify) 12 None used (open hole)
Blank casing diameter: 5 in. to 6 2 ft., Dia _____ in. to _____ ft., Dia _____ in. to _____ ft.
Casing height above land surface: 1.2 in., weight 1.75 lbs./ft. Wall thickness or gauge No. SDR-26
TYPE OF SCREEN OR PERFORATION MATERIAL:
1 Steel 2 Brass 3 Stainless steel 4 Galvanized steel 5 Fiberglass 6 Concrete tile 7 PVC 8 RMP (SR) 9 ABS 10 Asbestos-cement 11 Other (specify) 12 None used (open hole)
SCREEN OR PERFORATION OPENINGS ARE:
1 Continuous slot 2 Louvered shutter 3 Mill slot 4 Key punched 5 Gauzed wrapped 6 Wire wrapped 7 Torch cut 8 Saw cut 9 Drilled holes 10 Other (specify) 11 None (open hole)
SCREEN-PERFORATED INTERVALS: From 6 2 ft. to 8 2 ft., From _____ ft. to _____ ft., From _____ ft. to _____ ft.
GRAVEL PACK INTERVALS: From 4 5 ft. to 8 2 ft., From _____ ft. to _____ ft., From _____ ft. to _____ ft.

6 GROUT MATERIAL: 1 Neat cement 2 Cement grout 3 Bentonite 4 Other _____
Grout Intervals: From 0 ft. to 10 ft., From _____ ft. to _____ ft., From _____ ft. to _____ ft.
What is the nearest source of possible contamination:
1 Septic tank 2 Sewer lines 3 Watertight sewer lines 4 Lateral lines 5 Cess pool 6 Seepage pit 7 Pit privy 8 Sewage lagoon 9 Feedyard 10 Livestock pens 11 Fuel storage 12 Fertilizer storage 13 Insecticide storage 14 Abandoned water well 15 Oil well/Gas well 16 Other (specify below) PASSING CATTLE
Direction from well? _____ How many feet? _____

FROM	TO	LITHOLOGIC LOG	FROM	TO	LITHOLOGIC LOG
0	2	TOP SOIL			
2	11	Tan Clay			
11	16	BR. Clay			
16	35	Tan Clay			
35	82	GRAVEL			

7 CONTRACTOR'S OR LANDOWNER'S CERTIFICATION: This water well was (1) constructed, (2) reconstructed, or (3) plugged under my jurisdiction and was completed on (mo/day/year) 9-6-79 and this record is true to the best of my knowledge and belief. Kansas Water Well Contractor's License No. 224 This Water Well Record was completed on (mo/day/yr) 12-26-81 under the business name of Carl Anzse Water Well Serv by (signature) Carl Anzse
INSTRUCTIONS: Use typewriter or ball point pen PLEASE PRESS FIRMLY and PRINT clearly. Please fill in blanks, underline or circle the correct answers. Send top three copies to Kansas Department of Health and Environment, Division of Environment, Environmental Geology Section, Topeka, KS 66620. Send one to WATER WELL OWNER and retain one for your records.

OFFICE USE ONLY
T 28
R 19
E/W
SEC. 14
SE 1/4
SE 1/4
NW 1/4