


WATER WELL RECORD Form WWC-5 KSA 82a-1212

1 LOCATION OF WATER WELL: Fraction NW 1/4 NW 1/4 NE 1/4 Section Number 32 Township Number T 28 S Range Number R 19 W COUNTY: KIOWA

Distant and direction from nearest town or city street address of well if located within city? 1 MILE SOUTH, 3 MILES EAST OF MULLINVILLE

2 WATER WELL OWNER: SHERER, RICK RR#, St. Address, Box #: RR 1 City, State, ZIP code: MULLINVILLE, KS 67109- Board of Agriculture, Division of Water Resources Application Number:

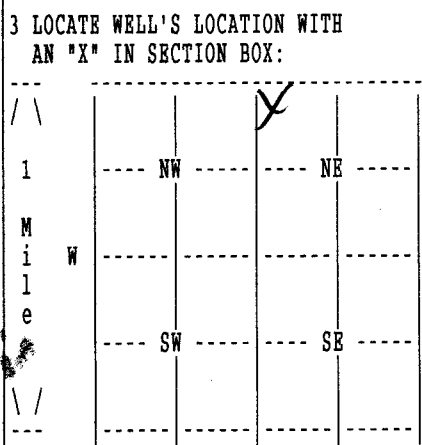

3 DEPTH OF COMPLETED WELL 180 ELEVATION: 0 Depth(s) Groundwater Encountered 1. 0 ft. 2. 0 ft. 3. 0 ft. WELL'S STATIC WATER LEVEL 140 ft. below land surface measured on mo/day/yr 06/15/05 Pump test data: Well water was 0 ft. after 0 hours pumping 0 gpm Estimated Yield 0 gpm: Well water was 0 ft. after 0 hours pumping 0 gpm Bore Hole Diameter 8.75 in. to 180 ft., and in. to 0 ft. WELL WATER TO BE USED AS: LIVESTOCK Was a chemical/bacteriological sample submitted to department? No; If yes, mo/day/yr sample was submitted Water well disinfected? Yes

5 TYPE OF BLANK CASING USED: PVC CASING JOINTS: GLUED Blank casing diameter 5 in. to 160 ft., Dia in. to 0 ft., Dia in. to 0 ft. Casing height above land surface 12 in., weight 0 lbs/ft. Wall thickness or gauge No. 21 TYPE OF SCREEN OR PERFORATION MATERIAL: PVC SCREEN OR PERFORATION OPENINGS ARE: SAW CUT

SCREEN PERFORATED INTERVALS: From 160 ft. to 180 ft., From 0 ft. to 0 ft. From 0 ft. to 0 ft., From 0 ft. to 0 ft. GRAVEL PACK INTERVALS: From 25 ft. to 180 ft., From 0 ft. to 0 ft. From 0 ft. to 0 ft., From 0 ft. to 0 ft.

6 GROUT MATERIAL BENTONITE Grout Intervals: From 4 ft. to 25 ft., From 0 ft. to 0 ft., From 0 ft. to 0 ft. What is the nearest source of possible contamination: SEPTIC TANK Direction from well? EAST How many feet? 2500

Table with columns: FROM, TO, LITHOLOGIC LOG, FROM, TO, PLUGGING INTERVALS. Rows include: 0-6 BROWN CLAY, 6-93 TAN CLAY, 93-142 SAND AND GRAVEL, 142-165 TAN CLAY, 165-178 BROWN ROCK SANDSTONE, 178-180 GRAY SHALE.

7 CONTRACTOR'S OR LANDOWNER'S CERTIFICATION: This water well was Constructed under my jurisdiction and was completed on (mo/day/year) 06/10/05 and this record is true to the best of my knowledge and belief. Kansas Water Well Contractor's License No. 653 This Water Well Record was completed on (mo/day/yr) 06/22/05 under the business name of DAN HAYSE WATER WELL SERV by (signature) Dan Hayse