

WATER WELL RECORD Form WWC-5 KSA 82a-1212


1 LOCATION OF WATER WELL: Fraction Section Number Township Number Range Number
COUNTY: KIOWA SE 1/4 SE 1/4 NE 1/4 5 T 28 S R 19 W

Distance and direction from nearest town or city street address of well if located within city?
3 MILES EAST, 3.5 MILES NORTH OF MULLINVILLE

2 WATER WELL OWNER: DOUGLASS, MILDRED
RR#, St. Address, Box #: 612 W IOWA LANE Board of Agriculture, Division of Water Resources
City, State, ZIP code: GREENSBURG, KS 67054- Application Number:

3 LOCATE WELL'S LOCATION WITH AN "X" IN SECTION BOX:

4 DEPTH OF COMPLETED WELL 170 ELEVATION: 0
Depth(s) Groundwater Encountered 1. 0 ft. 2. 0 ft. 3. 0 ft.

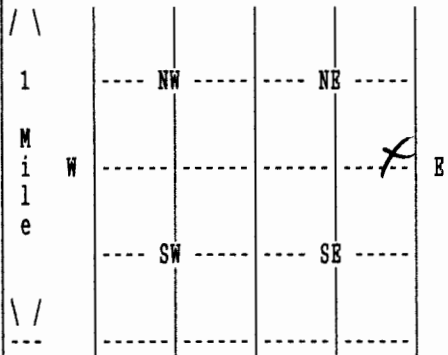

WELL'S STATIC WATER LEVEL 102 ft. below land surface measured on mo/day/yr 09/19/05
Pump test data: Well water was 0 ft. after 0 hours pumping 0 gpm
Estimated Yield 0 gpm: Well water was 0 ft. after 0 hours pumping 0 gpm
Bore Hole Diameter 8.75 in. to 170 ft., and in. to 0 ft.
WELL WATER TO BE USED AS: LIVESTOCK
Was a chemical/bacteriological sample submitted to department? No;
If yes, mo/day/yr sample was submitted Water well disinfected? Yes

5 TYPE OF BLANK CASING USED: PVC CASING JOINTS: GLUED
Blank casing diameter 5 in. to 150 ft., Dia in. to 0 ft., Dia in. to 0 ft.
Casing height above land surface 12 in., weight 0 lbs/ft. Wall thickness or gauge No. 26
TYPE OF SCREEN OR PERFORATION MATERIAL: PVC
SCREEN OR PERFORATION OPENINGS ARE: SAW CUT

SCREEN PERFORATED INTERVALS: From 150 ft. to 170 ft., From 0 ft. to 0 ft.
From 0 ft. to 0 ft., From 0 ft. to 0 ft.
GRAVEL PACK INTERVALS: From 25 ft. to 170 ft., From 0 ft. to 0 ft.
From 0 ft. to 0 ft., From 0 ft. to 0 ft.

6 GROUT MATERIAL BENTONITE
Grout Intervals: From 4 ft. to 25 ft., From 0 ft. to 0 ft., From 0 ft. to 0 ft.
What is the nearest source of possible contamination: SEPTIC TANK
Direction from well? WEST How many feet? 100

Table with columns: FROM, TO, LITHOLOGIC LOG, FROM, TO, PLUGGING INTERVALS. Rows list depth intervals and lithology: SILT AND SAND, TAN CLAY, SAND AND GRAVEL.

7 CONTRACTOR'S OR LANDOWNER'S CERTIFICATION: This water well was Constructed under my jurisdiction and was completed on (mo/day/year) 09/19/05 and this record is true to the best of my knowledge and belief. Kansas
Water Well Contractor's License No. 653 This Water Well Record was completed on (mo/day/yr) 12/30/05
under the business name of DAN HAYSE WATER WELL SERV by (signature) Dan Hayse