


WATER WELL RECORD Form WWC-5 KSA 82a-1212

1 LOCATION OF WATER WELL: Fraction SW 1/4 NE 1/4 NE 1/4 Section Number 16 Township Number T 28 S Range Number R 19 EW

Distance and direction from nearest town or city street address of well if located within city? 15994 Avenue 19, Greensburg

2 WATER WELL OWNER: ANR Pipeline Company RR#, St. Address, Box #: 717 Texas Street City, State, ZIP Code: Houston, TX 77002 Board of Agriculture, Division of Water Resources Application Number:

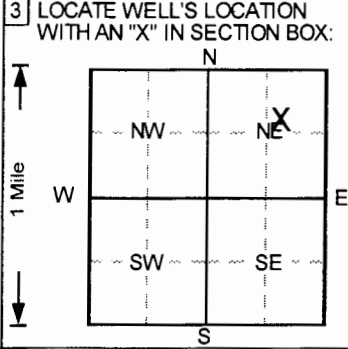

4 DEPTH OF COMPLETED WELL 110 ft. ELEVATION: Depth(s) Groundwater Encountered 1. 95 ft. 2. ft. 3. ft. WELL'S STATIC WATER LEVEL ft. below land surface measured on mo/day/yr Pump test data: Well water was NA ft. after hours pumping gpm Est. Yield NA gpm: Well water was ft. after hours pumping gpm Bore Hole Diameter 8.5 in. to 110 ft., and in. to ft. WELL WATER TO BE USED AS: 5 Public water supply 8 Air conditioning 11 Injection well 1 Domestic 3 Feedlot 6 Oil field water supply 9 Dewatering 12 Other (Specify below) 2 Irrigation 4 Industrial 7 Lawn and garden only 10 Monitoring well Was a chemical/bacteriological sample submitted to Department? Yes No If yes, mo/day/yr sample was submitted Water Well Disinfected? Yes No

5 TYPE OF BLANK CASING USED: 1 Steel 2 PVC 3 RMP (SR) 4 ABS 5 Wrought iron 6 Asbestos-Cement 7 Fiberglass 8 Concrete tile 9 Other (specify below) CASING JOINTS: Glued Clamped Welded Threaded Sch. 40 Blank casing diameter 2 in. to 80 ft., Dia in. to ft., Dia in. to ft. Casing height above land surface in., weight lbs./ft. Wall thickness or gauge No. TYPE OF SCREEN OR PERFORATION MATERIAL 1 Steel 2 Brass 3 Stainless steel 4 Galvanized steel 5 Fiberglass 6 Concrete tile 7 PVC 8 RMP (SR) 9 ABS 10 Asbestos-cement 11 Other (specify) 12 None used (open hole) SCREEN OR PERFORATION OPENINGS ARE: 1 Continuous slot 2 Louvered shutter 3 Mill slot 4 Key punched 5 Gauzed wrapped 6 Wire wrapped 7 Torch cut 8 Saw cut 9 Drilled holes 11 None (open hole) 10 Other (specify) SCREEN-PERFORATED INTERVALS: From 80 ft. to 110 ft., From ft. to ft. GRAVEL PACK INTERVALS: From 78 ft. to 110 ft., From ft. to ft.

6 GROUT MATERIAL: 1 Neat cement 2 Cement grout 3 Bentonite 4 Other Grout intervals: From 0 ft. to 2 ft., From 2 ft. to 78 ft., From ft. to ft. What is the nearest source of possible contamination: 1 Septic tank 2 Sewer lines 3 Watertight sewer lines 4 Lateral lines 5 Cess pool 6 Seepage pit 7 Pit privy 8 Sewage lagoon 9 Feedyard 10 Livestock pens 11 Fuel storage 12 Fertilizer storage 13 Insecticide storage 14 Abandoned water well 15 Oil well/Gas well 16 Other (specify below) Direction from well? How many feet?

Table with columns: FROM, TO, LITHOLOGIC LOG, FROM, TO, PLUGGING INTERVALS. Rows show soil layers: Silt, Strong Brown (0-25); Clay, silty, Reddish Yellow (25-35); Sand, f-m, Reddish Yellow (35-40); Silt, clayey, Reddish Yellow (40-50); Sand, Reddish Yellow (50-80); Sand, c, Reddish Yellow (80-110).

Table with columns: FROM, TO, LITHOLOGIC LOG, FROM, TO, PLUGGING INTERVALS. Includes a row for MW-5, Flushmount.

7 CONTRACTOR'S OR LANDOWNER'S CERTIFICATION: This water well was (1) constructed, (2) reconstructed, or (3) plugged under my jurisdiction and was completed on (mo/day/yr) 10/31/2012 and this record is true to the best of my knowledge and belief. Kansas Water Well Contractor's License No. 527 This Water Well Record was completed on (mo/day/yr) 11/30/12 under the business name of GeoCore, Inc. by (signature) Dale Bell

INSTRUCTIONS: Use typewriter or ball point pen. PLEASE PRESS FIRMLY and PRINT clearly. Please fill in blanks, underline or circle the correct answers. Send top three copies to Kansas Department of Health and Environment, Bureau of Water, Topeka, Kansas 66620-0001. Telephone: 913-296-5545. Send one to WATER WELL OWNER and retain one for your records.