

# WATER WELL PLUGGING RECORD Form WWC-5P

KSA 82a-1212

ID NO.

IW 8

<b>1 LOCATION OF WATER WELL:</b> County: <u>Kiowa</u>	Fraction <u>¼ sw ¼ ne ¼ ne ¼</u>	Section Number <u>16</u>	Township Number <u>T 28 S</u>	Range Number <u>19</u> <input type="checkbox"/> E <input checked="" type="checkbox"/> W
--	-------------------------------------	-----------------------------	----------------------------------	--

Street/Rural Address of Well Location; if unknown, distance & direction from nearest town or intersection: If at owner's address, check here ☐ ANR Pipeline Company  
15499 Avenue 19  
Greensburg, KS 67054


## Global Positioning Systems (GPS) information:

Latitude: 37.612822 (in decimal degrees)  
Longitude: -99.39705 (in decimal degrees)  
Elevation: 2280  
Horizontal Datum: ☒ WGS84, ☐ NAD83, ☐ NAD27  
Collection Method:

**2 WATER WELL OWNER:** ANR Pipeline Company  
RR#, St. Address, Box #: 717 Texas Avenue #2400  
City, State ZIP Code: Houston, TX 77002

☐ GPS unit (Make/Model: \_\_\_\_\_)  
☐ Digital Map/Photo, ☒ Topographic Map, ☐ Land Survey  
Est. Accuracy: ☒ < 3 m, ☐ 3-5 m, ☐ 5-15 m, ☐ > 15 m

## 3 MARK WELL'S LOCATION WITH AN "X" IN SECTION BOX:

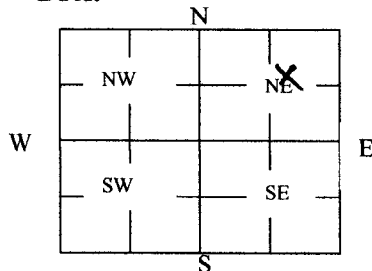

## 4 DEPTH OF WELL 85 ft.

WELL'S STATIC WATER LEVEL \_\_\_\_\_ ft

### WELL WAS USED AS:

- |                                     |   |  |
|-------------------------------------|---|--|
| <input type="checkbox"/> Domestic   | <input type="checkbox"/> Public Water Supply      | <input type="checkbox"/> Dewatering                |
| <input type="checkbox"/> Irrigation | <input type="checkbox"/> Oil Field Water Supply   | <input type="checkbox"/> Monitoring                |
| <input type="checkbox"/> Feedlot    | <input type="checkbox"/> Domestic (Lawn & Garden) | <input checked="" type="checkbox"/> Injection Well |
| <input type="checkbox"/> Industrial | <input type="checkbox"/> Air Conditioning         | <input type="checkbox"/> Other <u>IW-8</u>         |

Was a chemical/bacteriological sample submitted to Department? Yes ☐ No ☒

## 5 TYPE OF BLANK CASING USED:

- ☐ Steel ☐ RMP (SR) ☐ Wrought ☐ Fiberglass ☐ Other (Specify below)  
☒ PVC ☐ ABS ☐ Asbestos-Cement ☐ Concrete Tile

Blank casing diameter 2 in. Was casing pulled? Yes ☒ No ☐ If yes, how much 3-feet  
Casing height above or below land surface 0 in.

## 6 GROUT PLUG MATERIAL: ☐ Neat cement ☐ Cement grout ☒ Bentonite ☒ Other 0.5 to 3' Topsoil/Seed

Grout Plug Intervals: From 3 ft. to 85 ft., From N/A ft. to N/A ft., From N/A ft. to N/A ft.

What is the nearest source of possible contamination:

- |   |   |   |   |
|---|---|---|---|
| <input type="checkbox"/> Septic tank            | <input type="checkbox"/> Seepage pit    | <input type="checkbox"/> Fuel storage         | <input checked="" type="checkbox"/> Other (specify below) |
| <input type="checkbox"/> Sewer lines            | <input type="checkbox"/> Pit privy      | <input type="checkbox"/> Fertilizer storage   | <u>Natural Gas Compressor Station</u>                     |
| <input type="checkbox"/> Watertight sewer lines | <input type="checkbox"/> Sewage lagoon  | <input type="checkbox"/> Insecticide storage  |   |
| <input type="checkbox"/> Lateral lines          | <input type="checkbox"/> Feedyard       | <input type="checkbox"/> Abandoned water well | Direction from well? <u>Adjacent</u>                      |
| <input type="checkbox"/> Cess pool              | <input type="checkbox"/> Livestock pens | <input type="checkbox"/> Oil well/Gas well    | How many feet? <u>0-feet</u>                              |

FROM	TO	PLUGGING MATERIALS	FROM	TO	PLUGGING MATERIALS
0	0.5	Topsoil/Grass Seed			
0.5	85	Bentonite (hydrated)			

**7 CONTRACTOR'S OR LANDOWNER'S CERTIFICATION:** This water well was plugged under my jurisdiction and was completed on (mo/day/year) 8/10/2020 and this record is true to the best of my knowledge and belief. Kansas Water Well Contractor's License No. 759. This Water Well Record was completed on (mo/day/year) 8/22/2020 under the business name of RAZEK Environmental, LLC by (signature) [Signature]

Send one white copy to Kansas Department of Health & Environment, Geology Section, 1000 SW Jackson Street, Ste. 420, Topeka, KS 66612-1367. Send one copy to WATER WELL OWNER and retain one for your records.

Visit us at <http://www.kdheks.gov/waterwell/index.html> Telephone 785-296-5524.

KSA82a-1212

Revised 1/20/2015