


WATER WELL RECORD Form MWC-5 KSA 82a-1212

1 LOCATION OF WATER WELL: Fraction Section Number Township Number Range Number  
 COUNTY: 049 KIDWA SE 1/4 SW 1/4 SW 1/4 34 T 28 S R 19 W

Distance and direction from nearest town or city street address of well if located within city?  
 6 W. 3 S. OF GREENSBURG, KS.

2 WATER WELL OWNER: MRS. VIRGIL KOEHN 309  
 RR#, St. Address, Box #: RR.2 Board of Agriculture, Division of Water Resources  
 City, State, ZIP code: GREENSBURG, KS 67054- Application Number:

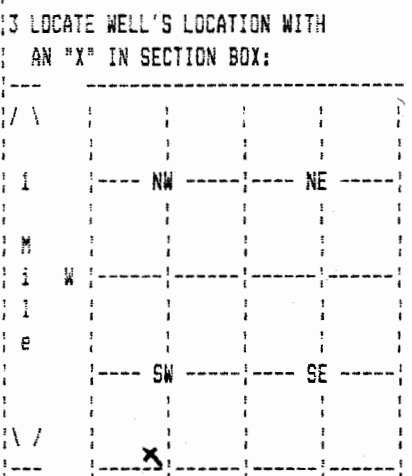

4 DEPTH OF COMPLETED WELL 132 ELEVATION: 0  
 Depth(s) Groundwater Encountered 1. 126 ft. 2. 0 ft. 3. 0 ft.  
 WELL'S STATIC WATER LEVEL 126 ft. below land surface measured on mo/day/yr  
 Pump test data: Well water was 0 ft. after 0 hours pumping 0 gpm  
 Estimated Yield 0 gpm: Well water was 0 ft. after 0 hours pumping 0 gpm  
 Bore Hole Diameter 2 in. to 132 ft., and in. to 0 ft.  
 WELL WATER TO BE USED AS: 01 DOMESTIC  
 Was a chemical/bacteriological sample submitted to department? No ;  
 If yes, mo/day/yr sample was submitted Water well disinfected? Yes

5 TYPE OF BLANK CASING USED: 01 STEEL CASING JOINTS: THREADED  
 Blank casing diameter 2 in. to 132 ft., Dia in. to 0 ft., Dia in. to 0 ft.  
 Casing height above land surface 16 in., weight 0 lbs/ft. Wall thickness or gauge No.  
 TYPE OF SCREEN OR PERFORATION MATERIAL: NONE USED  
 SCREEN OR PERFORATION OPENINGS ARE: 05 GAUZE WRAP.

SCREEN PERFORATED INTERVALS: From 130 ft. to 132 ft., From 0 ft. to 0 ft.  
 From 0 ft. to 0 ft., From 0 ft. to 0 ft.  
 GRAVEL PACK INTERVALS: From 0 ft. to 0 ft., From 0 ft. to 0 ft.  
 From 0 ft. to 0 ft., From 0 ft. to 0 ft.

6 GROUT MATERIAL 03 BENTONITE  
 Grout Intervals: From 3 ft. to 130 ft., From 0 ft. to 0 ft., From 0 ft. to 0 ft.  
 What is the nearest source of possible contamination: CATTLE PASTURE  
 Direction from well? E. How many feet? 5

FROM	TO	LITHOLOGIC LOG	FROM	TO	PLUGGING INTERVALS
			3	130	HOLEPLUS
			0	0	
			0	0	
			0	0	
			0	0	
			0	0	
			0	0	
			0	0	
			0	0	
			0	0	

7 CONTRACTOR'S OR LANDOWNER'S CERTIFICATION: This water well was Plugged under my jurisdiction and was completed on (mo/day/year) 2 /10/95 and this record is true to the best of my knowledge and belief. Kansas Water Well Contractor's License No. 224 This Water Well Record was completed on (mo/day/yr) 02/13/95 under the business name of CARL HAYSE WATER WELL SVC by (signature) Carl Hayse