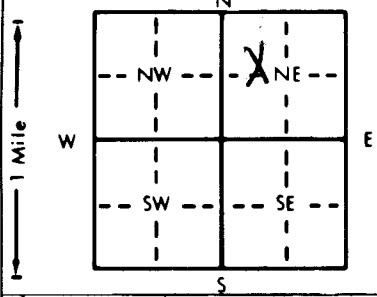


1 LOCATION OF WATER WELL: County: <u>Sedgwick</u> Fraction: <u>SW 1/4 NW 1/4 NE 1/4</u> Section Number: <u>23</u> Township Number: <u>T 28S</u> Range Number: <u>R 2E</u>					
Distance and direction from nearest town or city street address of well if located within city? <u>13910 W K-42</u>					
2 WATER WELL OWNER: <u>Lucille Siebert</u> RR#, St. Address, Box #: <u>13910 W K-42 6100 E Central</u> City, State, ZIP Code: <u>Winnetka KS 67208</u> Board of Agriculture, Division of Water Resources Application Number:					
3 LOCATE WELL'S LOCATION WITH AN "X" IN SECTION BOX: 	4 DEPTH OF COMPLETED WELL: <u>66</u> ft. ELEVATION: Depth(s) Groundwater Encountered 1. _____ ft. 2. _____ ft. 3. _____ ft. WELL'S STATIC WATER LEVEL: <u>12</u> ft. below land surface measured on mo/day/yr <u>8-8-96</u> Pump test data: Well water was _____ ft. after _____ hours pumping _____ gpm Est. Yield <u>25</u> gpm Well water was _____ ft. after _____ hours pumping _____ gpm Bore Hole Diameter: <u>11</u> in. to <u>66</u> ft. and _____ in. to _____ ft. WELL WATER TO BE USED AS: 1 Domestic <u>1</u> 3 Feedlot 6 Oil field water supply 9 Dewatering 12 Other (Specify below) 2 Irrigation 4 Industrial 7 Lawn and garden only 10 Monitoring well Was a chemical/bacteriological sample submitted to Department? Yes _____ No <u>X</u> If yes, mo/day/yr sample was submitted _____ Water Well Disinfected? Yes <u>X</u> No _____				
5 TYPE OF BLANK CASING USED: 1 Steel 3 RMP (SR) 5 Wrought iron 8 Concrete tile CASING JOINTS: Glued <u>X</u> Clamped 2 PVC <u>2</u> 4 ABS 6 Asbestos-Cement 9 Other (specify below) Welded Blank casing diameter _____ in. to <u>30</u> ft. Dia _____ in. to _____ ft. Dia _____ in. to _____ ft. Casing height above land surface _____ in., weight <u>2.40</u> lbs./ft. Wall thickness or gauge No. <u>PSI 160</u> TYPE OF SCREEN OR PERFORATION MATERIAL: 1 Steel 3 Stainless steel 5 Fiberglass 7 PVC 10 Asbestos-cement 2 Brass 4 Galvanized steel 6 Concrete tile 8 RMP (SR) 11 Other (specify) SCREEN OR PERFORATION OPENINGS ARE: 1 Continuous slot 3 Mill slot 5 Gauzed wrapped 8 Saw cut 11 None (open hole) 2 Louvered shutter 4 Key punched 6 Wire wrapped 9 Drilled holes SCREEN-PERFORATED INTERVALS: From <u>30</u> ft. to <u>66</u> ft. From _____ ft. to _____ ft. GRAVEL PACK INTERVALS: From <u>6</u> ft. to <u>66</u> ft. From _____ ft. to _____ ft.					
6 GROUT MATERIAL: 1 Neat cement 2 Cement grout 3 Bentonite 4 Other Grout Intervals: From <u>3</u> ft. to <u>23</u> ft. From _____ ft. to _____ ft. From _____ ft. to _____ ft. What is the nearest source of possible contamination: 1 Septic tank <u>1</u> 4 Lateral lines 7 Pit privy 10 Livestock pens 14 Abandoned water well 2 Sewer lines 5 Cess pool 8 Sewage lagoon 11 Fuel storage 15 Oil well/Gas well 3 Watertight sewer lines 6 Seepage pit 9 Feedyard 12 Fertilizer storage 16 Other (specify below) 13 Insecticide storage Direction from well? <u>Northwest</u> How many feet? <u>20 ft.</u>					
FROM	TO	LITHOLOGIC LOG	FROM	TO	PLUGGING INTERVALS
0	2	top soil			
2	29	clay			
29	32	sand			
32	66	charcoal shale			
7 CONTRACTOR'S OR LANDOWNER'S CERTIFICATION: This water well was <u>constructed</u> (2) reconstructed, or (3) plugged under my jurisdiction and was completed on (mo/day/year) <u>8-8-96</u> and this record is true to the best of my knowledge and belief. Kansas Water Well Contractor's License No. <u>318</u> This Water Well Record was completed on (mo/day/yr) <u>8-8-96</u> under the business name of <u>Weninger Drilling Inc</u> by (signature) <u>Michael Beck</u>					