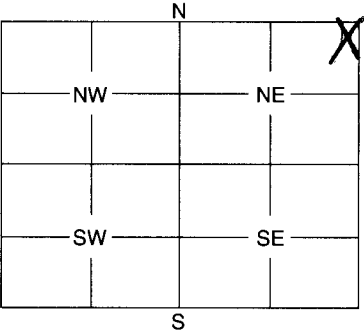


1	LOCATION OF WATER WELL: County <u>Sedgwick</u> Fraction <u>NE NE NE</u> $\frac{1}{4}$ $\frac{1}{4}$ $\frac{1}{4}$ Section Number <u>26</u> Township Number <u>28S</u> Range Number <u>2E</u>
---	--

Distance and direction from nearest town or city street address of well if located within city? 5510 S. 15th W.

2	WATER WELL OWNER: <u>Prudential Dining Beard</u> RR #, St. Address, Box #: _____ City, State, ZIP Code: _____ Board of Agriculture, Division of Water Resources Application Number: _____
---	---

3	MARK WELL'S LOCATION WITH AN "X" IN SECTION BOX: 	4	DEPTH OF WELL <u>50</u> ft. WELL'S STATIC WATER LEVEL <u>3</u> ft. WELL WAS USED AS: ☒ 1 Domestic ☐ 2 Irrigation ☐ 3 Feedlot ☐ 4 Industrial ☐ 5 Public Water Supply ☐ 6 Oil Field Water Supply ☐ 7 Domestic (Lawn & Garden) ☐ 8 Air Conditioning ☐ 9 Dewatering ☐ 10 Monitoring Well ☐ 11 Injection Well ☐ 12 Other _____ Was a chemical / bacteriological sample submitted to Department? Yes _____ No ☒ If yes, mo/day/yr sample was submitted _____ Water Well Disinfected: Yes ☒ No _____
---	---	---	---

5	TYPE OF BLANK CASING USED: ☒ Steel ☐ 3 RMP (SR) ☐ 5 Wrought ☐ 7 Fiberglass ☒ 9 Other (specify below) <u>stylene</u> ☒ PVC ☐ 4 ABS ☐ 6 Asbestos-Cement ☐ 8 Concrete Tile Blank casing diameter <u>5</u> in. Was casing pulled? Yes ☒ No _____ If yes, how much _____ Casing height above or below land surface <u>24</u> in.
---	--

6	GROUT PLUG MATERIAL: ☐ 1 Neat cement ☒ 2 Cement grout ☐ 3 Bentonite ☐ 4 Other _____ Grout Plug Intervals: From <u>10</u> ft. to <u>0</u> ft., From _____ ft. to _____ ft., From _____ ft. to _____ ft. What is the nearest source of possible contamination: ☒ 1 Septic tank ☐ 2 Sewer lines ☐ 3 Watertight sewer lines ☐ 4 Lateral lines ☐ 5 Cess pool ☐ 6 Seepage pit ☐ 7 Pit privy ☐ 8 Sewage lagoon ☐ 9 Feedyard ☐ 10 Livestock pens ☐ 11 Fuel storage ☐ 12 Fertilizer storage ☐ 13 Insecticide storage ☐ 14 Abandoned water well ☐ 15 Oil well/Gas well ☐ 16 Other (specify below) _____ Direction from well? <u>Northeast</u> How many feet? <u>30</u>
---	---

FROM	TO	PLUGGING MATERIALS
51	10	gravel
10	3	cement
3	0	topsoil

7	CONTRACTOR'S OR LANDOWNER'S CERTIFICATION: This water well was plugged under my jurisdiction and was completed on (mo/day/year) <u>4-24-04</u> and this record is true to the best of my knowledge and belief. Kansas Water Well Contractor's License No. <u>318</u> This Water Well Record was completed on (mo/day/year) <u>4-26-04</u> under the business name of <u>Centers Drilling Inc.</u> by (signature) <u>Michelle Ford</u>
---	--

INSTRUCTIONS: Use typewriter or ball point pen. Please press firmly and print clearly. Please fill in blanks, underline or circle the correct answers. Send top three copies to Kansas Department of Health and Environment, Bureau of Water, Geology Section, 1000 SW Jackson St., Ste. 420, Topeka, Kansas 66612-1367. Telephone: 785/296-5522. Send one to Water Well Owner and retain one for your records.