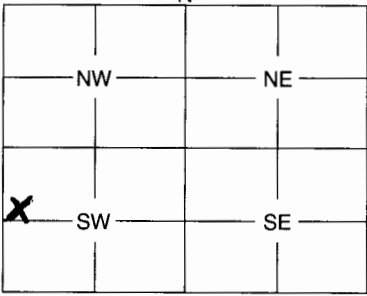


1	LOCATION OF WATER WELL:	Fraction	Section Number	Township Number	Range Number																								
	County: <u>Sedgewick</u> <u>SW 1/4 NW 1/4 SW 1/4</u>		<u>10</u>	<u>28 S.</u>	<u>2</u> EW																								
Distance and direction from nearest town or city street address of well if located within city? <u>3556 S. 167th W.</u>																													
2	WATER WELL OWNER: <u>Bob Cates.</u> RR #, St. Address, Box #: <u>3556 S. 167th W.</u> City, State, ZIP Code: <u>Goodland, KS 67052</u>																												
Board of Agriculture, Division of Water Resources Application Number: _____																													
3	MARK WELL'S LOCATION WITH AN "X" IN SECTION BOX:		4																										
		DEPTH OF WELL <u>82</u> ft.																											
		WELL'S STATIC WATER LEVEL <u>29</u> ft. (<u>Basement</u>)																											
		WELL WAS USED AS:																											
		☒ 1 Domestic ☐ 2 Irrigation ☐ 3 Feedlot ☐ 4 Industrial			☐ 5 Public Water Supply ☐ 6 Oil Field Water Supply ☐ 7 Domestic (Lawn & Garden) ☐ 8 Air Conditioning	☐ 9 Dewatering ☐ 10 Monitoring Well ☐ 11 Injection Well ☐ 12 Other																							
		Was a chemical / bacteriological sample submitted to Department? Yes No ☒																											
		If yes, mo/day/yr sample was submitted																											
		Water Well Disinfected: Yes ☒ No																											
5	TYPE OF BLANK CASING USED:																												
☒ 1 Steel 3 RMP (SR) 5 Wrought 7 Fiberglass 9 Other (Specify below) _____ ☐ 2 PVC 4 ABS 6 Asbestos-Cement 8 Concrete Tile																													
Blank casing diameter <u>5</u> in. Was casing pulled? Yes No ☒ If yes, how much																													
Casing height above or below land surface <u>12</u> in. (<u>Basement</u>)																													
6	GROUT PLUG MATERIAL: 1 Neat cement 2 Cement grout ☒ 3 Bentonite 4 Other																												
Grout Plug Intervals: From <u>1</u> ft. to <u>20</u> ft., From ft. to ft., From to ft.																													
What is the nearest source of possible contamination:																													
☐ 1 Septic tank ☐ 6 Seepage pit ☐ 11 Fuel storage ☐ 16 Other (specify below) _____ ☐ 2 Sewer lines ☐ 7 Pit privy ☐ 12 Fertilizer storage ☒ 3 Watertight sewer lines ☐ 8 Sewage lagoon ☐ 13 Insecticide storage ☐ 4 Lateral lines ☐ 9 Feedyard ☐ 14 Abandoned water well ☐ 5 Cess pool ☐ 10 Livestock pens ☐ 15 Oil well/Gas well																													
Direction from well? <u>South</u> How many feet? <u>12</u>																													
<table border="1" style="width:100%; border-collapse: collapse;"> <thead> <tr> <th style="width:15%;">FROM</th> <th style="width:15%;">TO</th> <th style="width:70%;">PLUGGING MATERIALS</th> </tr> </thead> <tbody> <tr> <td><u>0</u></td> <td><u>1</u></td> <td><u>Neat Cement</u></td> </tr> <tr> <td><u>1</u></td> <td><u>20</u></td> <td><u>Bentonite</u></td> </tr> <tr> <td><u>20</u></td> <td><u>82</u></td> <td><u>Well Gravel</u></td> </tr> <tr><td> </td><td> </td><td> </td></tr> <tr><td> </td><td> </td><td> </td></tr> <tr><td> </td><td> </td><td> </td></tr> <tr><td> </td><td> </td><td> </td></tr>
7	CONTRACTOR'S OF LANDOWNER'S CERTIFICATION: This water well was plugged under my jurisdiction and was completed on (mo/day/year) <u>5-4-95</u> and this record is true to the best of my knowledge and belief. Kansas Water Well Contractor's License No. <u>7740</u> This Water Well Record was completed on (mo/day/year) <u>5-5-95</u> under the business name of <u>Whitinger Drilling Inc.</u> by (signature) <u>[Signature]</u>																												

INSTRUCTIONS: Use typewriter or ball point pen. Please press firmly and print clearly. Please fill in blanks, underline or circle the correct answers. Send top three copies to Kansas Department of Health and Environment, Bureau of Water, Geology Section, 1000 SW Jackson St., Ste. 420, Topeka, Kansas 66612-1367. Telephone: 785/296-5522. Send one to Water Well Owner and retain one for your records.