

# WATER WELL PLUGGING RECORD Form WWC-5P

KSA 82a-1212

ID NO.

|                                                      |                              |                      |                           |                                                                                    |
|------------------------------------------------------|------------------------------|----------------------|---------------------------|------------------------------------------------------------------------------------|
| <b>1 LOCATION OF WATER WELL:</b><br>County: SEDGWICK | Fraction<br>¼ NE ¼ NE ¼ NE ¼ | Section Number<br>16 | Township Number<br>T 28 S | Range Number<br>2 <input type="checkbox"/> E <input checked="" type="checkbox"/> W |
|------------------------------------------------------|------------------------------|----------------------|---------------------------|------------------------------------------------------------------------------------|

Street/Rural Address of Well Location; if unknown, distance & direction from nearest town or intersection: If at owner's address, check here ☐ 3 MILES EAST & 3 MILES SOUTH OF GODDARD,

KANSAS

**2 WATER WELL OWNER:** BILL JOHNSON  
RR#, St. Address, Box #: 167TH STREET  
City, State ZIP Code: GODDARD, KS 67052

## Global Positioning Systems (GPS) information:

Latitude: \_\_\_\_\_ (in decimal degrees)

Longitude: \_\_\_\_\_ (in decimal degrees)

Elevation: \_\_\_\_\_

Datum: ☐ WGS84, ☐ NAD83, ☐ NAD27


Collection Method:

☐ GPS unit (Make/Model: \_\_\_\_\_)

☐ Digital Map/Photo, ☐ Topographic Map, ☐ Land Survey

Est. Accuracy: ☐ < 3 m, ☐ 3-5 m, ☐ 5-15 m, ☐ > 15 m

## 3 MARK WELL'S LOCATION WITH AN "X" IN SECTION BOX:

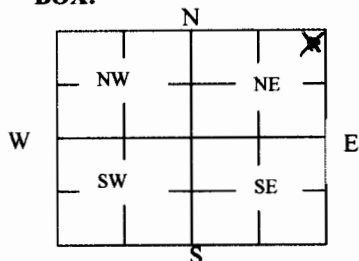

## 4 DEPTH OF WELL 2-185& 2-200 ft. (4 wells)

WELL'S STATIC WATER LEVEL 30 ft

WELL WAS USED AS:

☐ Domestic  
☐ Irrigation  
☐ Feedlot  
☐ Industrial

☐ Public Water Supply  
☐ Oil Field Water Supply  
☐ Domestic (Lawn & Garden)  
☐ Air Conditioning

☐ Dewatering  
☐ Monitoring  
☐ Injection Well  
☒ Other GEO-THERMAL

Was a chemical/bacteriological sample submitted to Department? Yes ☐ No ☒

## 5 TYPE OF BLANK CASING USED:

☐ Steel  
☐ PVC

☐ RMP (SR)  
☐ ABS

☐ Wrought  
☐ Asbestos-Cement

☐ Fiberglass  
☐ Concrete Tile

☒ Other (Specify below)  
POLYETHYLENE

Blank casing diameter \_\_\_\_\_ in. Was casing pulled? Yes ☐ No ☒ If yes, how much \_\_\_\_\_  
Casing height above or below land surface \_\_\_\_\_ in.

## 6 GROUT PLUG MATERIAL: ☐ Neat cement ☐ Cement grout ☒ Bentonite ☐ Other \_\_\_\_\_

Grout Plug Intervals: From 0 ft. to 185 ft., From 0 ft. to 185 ft., From 0 to 200 ft.  
0 ft. to 200 ft.

What is the nearest source of possible contamination:

☐ Septic tank  
☐ Sewer lines  
☐ Watertight sewer lines  
☐ Lateral lines  
☐ Cess pool

☐ Seepage pit  
☐ Pit privy  
☒ Sewage lagoon  
☐ Feedyard  
☐ Livestock pens

☐ Fuel Storage  
☐ Fertilizer storage  
☐ Insecticide storage  
☐ Abandoned water well  
☐ Oil well/Gas well

☐ Other (specify below)

Direction from well? SOUTHWEST  
How many feet? 300

| FROM | TO  | PLUGGING MATERIALS       | FROM | TO | PLUGGING MATERIALS |
|------|-----|--------------------------|------|----|--------------------|
|      |     | LITHOLOGIC LOG           |      |    |                    |
| 0    | 3   | TOPSOIL                  |      |    |                    |
| 3    | 9   | CLAY, TAN                |      |    |                    |
| 9    | 19  | SAND, FINE TO MEDIUM     |      |    |                    |
| 19   | 55  | SHALE, GRAY              |      |    |                    |
| 55   | 200 | SHALE, RED, GRAY & GREEN |      |    |                    |

**7 CONTRACTOR'S OR LANDOWNER'S CERTIFICATION:** This water well was plugged under my jurisdiction and was completed on (mo/day/year) 6/15/09 and this record is true to the best of my knowledge and belief. Kansas Water Well Contractor's License No. 138. This Water Well Record was completed on (mo/day/year) 6/30/09 under the business name of PETERSON IRRIGATION, INC. by (signature) Mike Peters

**INSTRUCTIONS:** Use typewriter or ballpoint pen. Please press firmly and print clearly. Please fill in blanks, underline or circle the correct answers. Send top three copies to Kansas Department of Health and Environment, Bureau of Water, Geology Section, 1000 SW Jackson St., Ste. 420, Topeka, Kansas 66612-1367. Telephone: 785/296-5524. Send one to Water Well Owner and retain one for your records. Visit us at <http://www.kdheks.gov/waterwell/index.html>.

Check one: ☒ White Copy ☐ Blue Copy ☐ Pink Copy