

**WATER WELL RECORD Form WWC-5**

Division of Water Resources App. No.


Well ID

Original Record  Correction  Change in Well Use

**1 LOCATION OF WATER WELL:** County: Sedgewick Fraction: ne 1/4 ne 1/4 nw 1/4 Section Number: 1 Township Number: T 28 S Range Number: R 2 E W

**2 WELL OWNER:** Last Name: Joe Vanderhill First:  Street or Rural Address where well is located (if unknown, distance and direction from nearest town or intersection): If at owner's address, check here:  2428 S. Monument Wichita, KS 67235

Business:  Address:  City:  State:  ZIP:

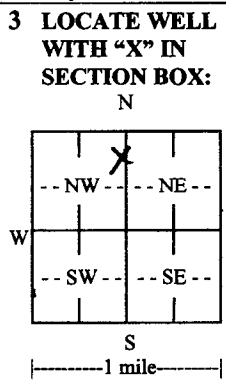

**4 DEPTH OF COMPLETED WELL:** 103 ft.

Depth(s) Groundwater Encountered: 1)  ft. 2)  ft. 3)  ft., or 4)  Dry Well

WELL'S STATIC WATER LEVEL:  ft.

below land surface, measured on (mo-day-yr).....  
 above land surface, measured on (mo-day-yr).....

Pump test data: Well water was  ft. after  hours pumping  gpm  
 Well water was  ft. after  hours pumping  gpm

Estimated Yield: 20 gpm

Bore Hole Diameter:  in. to  ft. and  in. to  ft.

**5 Latitude:**  (decimal degrees)  
**Longitude:**  (decimal degrees)  
 Datum:  WGS 84  NAD 83  NAD 27  
**Source for Latitude/Longitude:**  
 GPS (unit make/model: ) (WAAS enabled?  Yes  No)  
 Land Survey  Topographic Map  
 Online Mapper:

**6 Elevation:**  ft.  Ground Level  TOC  
**Source:**  Land Survey  GPS  Topographic Map  
 Other

**7 WELL WATER TO BE USED AS:**

1. Domestic:  Household  Lawn & Garden  Livestock  
 2.  Irrigation  
 3.  Feedlot  
 4.  Industrial

5.  Public Water Supply: well ID   
 6.  Dewatering: how many wells?   
 7.  Aquifer Recharge: well ID   
 8.  Monitoring: well ID   
 9. Environmental Remediation: well ID   
 Air Sparge  Soil Vapor Extraction  Recovery  Injection

10.  Oil Field Water Supply: lease   
 11. Test Hole: well ID   
 Cased  Uncased  Geotechnical  
 12. Geothermal: how many bores?   
 a) Closed Loop  Horizontal  Vertical  
 b) Open Loop  Surface Discharge  Inj. of Water  
 13.  Other (specify):

Was a chemical/bacteriological sample submitted to KDHE?  Yes  No If yes, date sample was submitted:

Water well disinfected?  Yes  No

**8 TYPE OF CASING USED:**  Steel  PVC  Other  CASING JOINTS:  Glued  Clamped  Welded  Threaded

Casing diameter  in. to  ft., Diameter  in. to  ft., Diameter  in. to  ft.  
 Casing height above land surface  in. Weight  lbs./ft. Wall thickness or gauge No. 160

TYPE OF SCREEN OR PERFORATION MATERIAL:  
 Steel  Stainless Steel  Fiberglass  PVC  Other (Specify)   
 Brass  Galvanized Steel  Concrete tile  None used (open hole)

SCREEN OR PERFORATION OPENINGS ARE:  
 Continuous Slot  Mill Slot  Gauze Wrapped  Torch Cut  Drilled Holes  Other (Specify)   
 Louvered Shutter  Key Punched  Wire Wrapped  Saw Cut  None (Open Hole)

SCREEN-PERFORATED INTERVALS: From 56 ft. to 100 ft., From  ft. to  ft., From  ft. to  ft.  
 GRAVEL PACK INTERVALS: From 51 ft. to 103 ft., From  ft. to  ft., From  ft. to  ft.

**9 GROUT MATERIAL:**  Neat cement  Cement grout  Bentonite  Other

Grout Intervals: From 3 ft. to 31 ft., From  ft. to  ft., From  ft. to  ft.

Nearest source of possible contamination:  
 Septic Tank  Lateral Lines  Pit Privy  Livestock Pens  Insecticide Storage  
 Sewer Lines  Cess Pool  Sewage Lagoon  Fuel Storage  Abandoned Water Well  
 Watertight Sewer Lines  Seepage Pit  Feedyard  Fertilizer Storage  Oil Well/Gas Well  
 Other (Specify)

Direction from well? East Distance from well? 24 ft.

10 FROM	TO	LITHOLOGIC LOG	FROM	TO	LITHO. LOG (cont.) or PLUGGING INTERVALS
0	1	Top Soil			
1	20	Clay			
20	30	clay / fine sand			
30	34	med sand			
34	50	clay			
50	56	med. gravel			
56	62	Clay			Notes:
62	102	Shale			
102	103	Gypsum Rock			

**11 CONTRACTOR'S OR LANDOWNER'S CERTIFICATION:** This water well was  constructed,  reconstructed, or  plugged under my jurisdiction and was completed on (mo-day-year) 2-19-15 and this record is true to the best of my knowledge and belief. Kansas Water Well Contractor's License No. 824 This Water Well Record was completed on (mo-day-year) 2-24-15 under the business name of Wenger Drilling