


WATER WELL RECORD Form WWC-5 KSA 82a-1212

1 LOCATION OF WATER WELL: Sedgwick	FRACTION NW 1/4 SW 1/4 NE 1/4	SECTION NUMBER 12	TOWNSHIP NUMBER T 28 S	RANGE NUMBER R 2W E/W
--	---	-----------------------------	----------------------------------	---------------------------------

Distance and direction from nearest town or city street address of well if located within city?
3525 S Firefly Wichita, Kansas

2 WATER WELL OWNER: Museousky, Nick	Board of Agriculture, Division of Water Resource
RR#,ST. ADDRESS,BOX #: P.O. Box 3974	Application Number:
CITY, STATE: Wichita, Kansas	ZIP CODE:

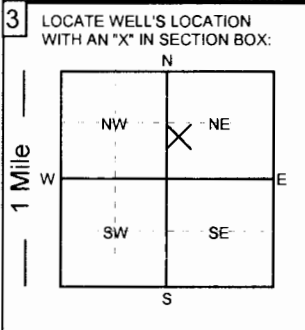

4 DEPTH OF COMPLETED WELL: 116 ft.	ELEVATION:
Depth of groundwater Encountered: _____ ft.	_____ ft.
WELL'S STATIC WATER LEVEL 15 FT. BELOW LAND SURFACE MEASURED ON 12/22/15	mo/day/yr: _____
Pump test data: Well water was _____ ft. after _____ hours of pumping @ _____ gpm	
Est. Yield: _____ gpm Well water was _____ ft. after _____ hours of pumping @ _____ gpm	
Bore Hole Diameter 12 in. to 116 ft. and _____ in. to _____ ft.	
WELL WATER TO BE USED AS:	
<input checked="" type="checkbox"/> 1. Domestic <input type="checkbox"/> 3. Feedlot <input type="checkbox"/> 5. Public water supply <input type="checkbox"/> 7. Lawn and garden only <input type="checkbox"/> 9. Dewatering <input type="checkbox"/> 11. Injection well	
<input type="checkbox"/> 2. Irrigation <input type="checkbox"/> 4. Industrial <input type="checkbox"/> 6. Oil field water supply <input type="checkbox"/> 8. Air conditioning <input type="checkbox"/> 10. Monitoring well	
Was a chemical/bacteriological sample submitted to Department? YES <input checked="" type="checkbox"/> NO ; If yes, what mo/day/yr was sample submitted _____	
Was Water Well Disinfected? <input checked="" type="checkbox"/> YES <input type="checkbox"/> NO	

5 TYPE OF CASING USED:	CASING JOINTS: <input checked="" type="checkbox"/> Glued <input type="checkbox"/> Threaded
1. Steel 3. RPM (SR)	<input type="checkbox"/> Welded <input type="checkbox"/> Clamped
<input checked="" type="checkbox"/> 2. PVC 4. ABS	SDR-26
5. Wrought Iron 7. Fiberglass 9. Other (Specify below)	
6. Asbestos-Cement 8. Concrete tile	
Blank casing diameter 5 in. to 91 ft., Dia. _____ in. to _____ ft.	
Casing height above land surface: 12 in., Weight: 2.35 lbs. / ft.	Wall thickness or gauge No. .214
TYPE OF SCREEN OR PERFORATION MATERIAL:	
1. Steel 3. Stainless Steel 5. Fiberglass <input checked="" type="checkbox"/> 7. PVC 9. ABS 11. Other (specify)	
2. Brass 4. Galvanized 6. Concrete Tile 8. RMP (SR) 10. Asbestos-Cement 12. None used (open hole)	
SCREEN OR PERFORATION OPENINGS ARE:	
1. Continuous slot 3. Mill slot 5. Gauzed wrapped 7. Torch cut 9. Drilled holes 11. None (open hole)	
2. Louvered shutter 4. Key punched 6. Wire wrapped <input checked="" type="checkbox"/> 8. Saw cut 10. Other (specify)	
SCREEN - PERFORATION INTERVAL	From 91 ft. to 116 ft., From _____ ft. to _____ ft.
GRAVEL PACK INTERVALS:	From 24 ft. to 116 ft., From _____ ft. to _____ ft.

6 GROUT MATERIALS:	Other bentonite hole plug
1. Neat cement 2. Cement Grout 3. Bentonite	
Grout intervals: From 4 ft. to 24 ft., From _____ ft. to _____ ft.	
What is the nearest source of possible contamination:	
1. Septic tank 4. Lateral lines 7. Pit privy 10. Livestock pens 13. Insecticide storage 15. Oil well/Gas well	
2. Sewer lines 5. Cess Pool 8. Sewage lagoon 11. Fuel storage 14. Abandon water well 16. Other (specify below)	
3. Watertight sewer line 6. Seepage pit 9. Feed yard 12. Fertilizer storage	None Yet
Direction from well? _____	How many feet? _____

From	To	LITHOLOGIC LOG	From	To	LITHOLOGIC LOG
0	3	topsoil			
3	50	clay			
50	65	fine sand			
65	92	clay			
92	99	medium sand			
99	106	red shale			
106	116	grey shale			

7 Contractor's or Landowner's Certification: This water well was <input checked="" type="checkbox"/> constructed <input type="checkbox"/> reconstructed or <input type="checkbox"/> plugged under my jurisdiction and was completed on (mo/day/year) 12/22/2015 and this record is true to the best of my knowledge and belief.	
Kansas Water Well Contractor's License No. 236	This water well record was completed on (mo/day/year) 12/23/15
under the business name of Harp Well and Pump Service	by (signature) Todd S. Harp