

**WATER WELL RECORD Form WWC-5**


Division of Water Resources App. No.  

Well ID  

Original Record  Correction  Change in Well Use

**1 LOCATION OF WATER WELL:** County: Sedgewick Fraction: SE 1/4 SW 1/4 NE 1/4 Section Number: 12 Township Number: T 28 S Range Number: R 2 E W

**2 WELL OWNER:** Last Name: Tony Gromley First: Gromley Street or Rural Address where well is located (if unknown, distance and direction from nearest town or intersection): If at owner's address, check here:   
 Business: Wichita State: Ks ZIP: 67227 3533 S. Cedar Downs  
 Address: Wichita  
 City: Wichita

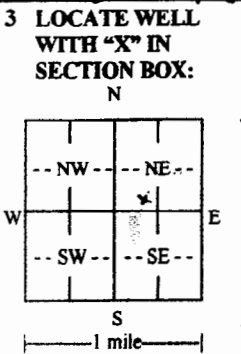

**4 DEPTH OF COMPLETED WELL:** 180 ft.  
 Depth(s) Groundwater Encountered: 1) 68 ft. 2) 87.21.15 ft. 3) 87.21.15 ft. or 4)  Dry Well  
 WELL'S STATIC WATER LEVEL: 68 ft.  below land surface, measured on (mo-day-yr) 8/21/15  
 above land surface, measured on (mo-day-yr)    
 Pump test data: Well water was   ft. after   hours pumping   gpm  
 Well water was   ft. after   hours pumping   gpm  
 Estimated Yield: 25 gpm  
 Bore Hole Diameter: 9 in. to 180 ft. and   in. to   ft.

**5 Latitude:**   (decimal degrees)  
**Longitude:**   (decimal degrees)  
 Horizontal Datum:  WGS 84  NAD 83  NAD 27  
 Source for Latitude/Longitude:  
 GPS (unit make/model:  ) (WAAS enabled?  Yes  No)  
 Land Survey  Topographic Map  
 Online Mapper:    
**6 Elevation:**   ft.  Ground Level  TOC  
 Source:  Land Survey  GPS  Topographic Map  
 Other:  

**7 WELL WATER TO BE USED AS:**

1. Domestic: <input checked="" type="checkbox"/> Household	5. <input type="checkbox"/> Public Water Supply: well ID <u> </u>	10. <input type="checkbox"/> Oil Field Water Supply: lease <u> </u>
2. <input type="checkbox"/> Irrigation	6. <input type="checkbox"/> Dewatering: how many wells? <u> </u>	11. Test Hole: well ID <u> </u>
3. <input type="checkbox"/> Feedlot	7. <input type="checkbox"/> Aquifer Recharge: well ID <u> </u>	<input type="checkbox"/> Cased <input type="checkbox"/> Uncased <input type="checkbox"/> Geotechnical
4. <input type="checkbox"/> Industrial	8. <input type="checkbox"/> Monitoring: well ID <u> </u>	12. Geothermal: how many bores? <u> </u>
	9. Environmental Remediation: well ID <u> </u>	a) Closed Loop <input type="checkbox"/> Horizontal <input type="checkbox"/> Vertical
	<input type="checkbox"/> Air Sparge <input type="checkbox"/> Soil-Vapor Extraction	b) Open Loop <input type="checkbox"/> Surface Discharge <input type="checkbox"/> Inj. of Water
	<input type="checkbox"/> Recovery <input type="checkbox"/> Injection	13. <input type="checkbox"/> Other (specify): <u> </u>

Was a chemical/bacteriological sample submitted to KDHE?  Yes  No If yes, date sample was submitted:    
 Water well disinfected?  Yes  No

**8 TYPE OF CASING USED:**  Steel  PVC  Other   CASING JOINTS:  Glued  Clamped  Welded  Threaded  
 Casing diameter 5 in. to   ft. Diameter   in. to   ft. Diameter   in. to   ft.  
 Casing height above land surface 12 in. Weight   lbs./ft. Wall thickness or gauge No. 160 PSI  
 TYPE OF SCREEN OR PERFORATION MATERIAL:  
 Steel  Stainless Steel  Fiberglass  PVC  Other (Specify)    
 Brass  Galvanized Steel  Concrete tile  None used (open hole)  
 SCREEN OR PERFORATION OPENINGS ARE:  
 Continuous Slot  Mill Slot  Gauze Wrapped  Torch Cut  Drilled Holes  Other (Specify)    
 Louvered Shutter  Key Punched  Wire Wrapped  Saw Cut  None (Open Hole)  
 SCREEN-PERFORATED INTERVALS: From 120 ft. to 180 ft. From   ft. to   ft. From   ft. to   ft.  
 GRAVEL PACK INTERVALS: From 34 ft. to 180 ft. From   ft. to   ft. From   ft. to   ft.

**9 GROUT MATERIAL:**  Neat cement  Cement grout  Bentonite  Other    
 Grout Intervals: From 3 ft. to 34 ft. From   ft. to   ft. From   ft. to   ft.  
 Nearest source of possible contamination:  
 Septic Tank  Lateral Lines  Pit Privy  Livestock Pens  Insecticide Storage  
 Sewer Lines  Cess Pool  Sewage Lagoon  Fuel Storage  Abandoned Water Well  
 Watertight Sewer Lines  Seepage Pit  Feedyard  Fertilizer Storage  Oil Well/Gas Well  
 Other (Specify)    
 Direction from well? West Distance from well? 100+ ft.

10 FROM	TO	LITHOLOGIC LOG	FROM	TO	LITHO. LOG (cont.) or PLUGGING INTERVALS
0	1	TOP SOIL			
1	20	clay			
20	30	med sand (Red)			
30	136	Clay			
136	139	med gravel			
139	180	Shale			
					Notes:

**11 CONTRACTOR'S OR LANDOWNER'S CERTIFICATION:** This water well was  constructed,  reconstructed, or  plugged under my jurisdiction and was completed on (mo-day-yr) 8-20-15 and this record is true to the best of my knowledge and belief. Kansas Water Well Contractor's License No.  . This Water Well Record was completed on (mo-day-yr) 8-21-15 under the business name of Weninger Drilling Signature