


WATER WELL RECORD Form WWC-5 KSA 82a-1212

1 LOCATION OF WATER WELL: Sedgwick	FRACTION NE 1/4 NE 1/4 NE 1/4	SECTION NUMBER 3	TOWNSHIP NUMBER T 28 S	RANGE NUMBER R 2W E/W
--	---	----------------------------	----------------------------------	---------------------------------

Distance and direction from nearest town or city street address of well if located within city?

2565 S. Saratoga Ct. Wichita, Kansas

2 WATER WELL OWNER: H & H HOMEBUILDERS INC.	Board of Agriculture, Division of Water Resource
RR#, ST. ADDRESS, BOX #: 3906 N. Lakecrest	Application Number:
CITY, STATE: Wichita, Kansas	ZIP CODE:

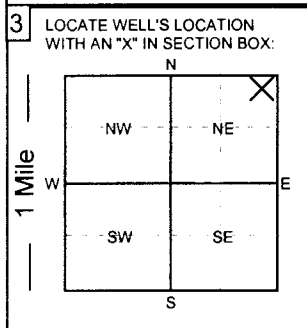

4 DEPTH OF COMPLETED WELL: 130 ft.	ELEVATION:
Depth of groundwater Encountered: _____ ft.	_____ ft.
WELL'S STATIC WATER LEVEL 30 FT. BELOW LAND SURFACE MEASURED ON 11/23/16	
Pump test data: Well water was _____ ft. after _____ hours of pumping @ _____ gpm	
Est. Yield: _____ gpm Well water was _____ ft. after _____ hours of pumping @ _____ gpm	
Bore Hole Diameter 12 in. to 130 ft. and _____ in. to _____ ft.	
WELL WATER TO BE USED AS:	
<input checked="" type="checkbox"/> 1. Domestic <input type="checkbox"/> 3. Feedlot <input type="checkbox"/> 5. Public water supply <input type="checkbox"/> 7. Lawn and garden only <input type="checkbox"/> 9. Dewatering <input type="checkbox"/> 11. Injection well	
<input type="checkbox"/> 2. Irrigation <input type="checkbox"/> 4. Industrial <input type="checkbox"/> 6. Oil field water supply <input type="checkbox"/> 8. Air conditioning <input type="checkbox"/> 10. Monitoring well <input type="checkbox"/> 12. Other (Specify below)	
Was a chemical/bacteriological sample submitted to Department? YES <input checked="" type="checkbox"/> NO ; If yes, what mo/day/yr was sample submitted _____	
Was Water Well Disinfected? <input checked="" type="checkbox"/> YES <input type="checkbox"/> NO	

5 TYPE OF CASING USED:	5. Wrought Iron	7. Fiberglass	9. Other (Specify below)	CASING JOINTS: <input checked="" type="checkbox"/> Glued <input type="checkbox"/> Threaded
1. Steel	3. RPM (SR)			<input type="checkbox"/> Welded <input type="checkbox"/> Clamped
<input checked="" type="checkbox"/> 2. PVC <input type="checkbox"/> 4. ABS	6. Asbestos-Cement	8. Concrete tile	SDR-26	
Blank casing diameter 5 in. to 35 ft., Dia. _____ in. to _____ ft.				
Casing height above land surface: 12 in., Weight: 2.35 lbs. / ft. Wall thickness or gauge No. .214				
TYPE OF SCREEN OR PERFORATION MATERIAL:				
1. Steel	3. Stainless Steel	5. Fiberglass	<input checked="" type="checkbox"/> 7. PVC	9. ABS
2. Brass	4. Galvanized	6. Concrete Tile	8. RMP (SR)	10. Asbestos-Cement
				11. Other (specify)
				12. None used (open hole)
SCREEN OR PERFORATION OPENINGS ARE:				
1. Continuous slot	3. Mill slot	5. Gauzed wrapped	7. Torch cut	9. Drilled holes
2. Louvered shutter	4. Key punched	6. Wire wrapped	<input checked="" type="checkbox"/> 8. Saw cut	10. Other (specify)
11. None (open hole)				
SCREEN - PERFORATION INTERVAL	From 35 ft. to 130 ft.,	From _____ ft. to _____ ft.		
GRAVEL PACK INTERVALS:	From 24 ft. to 130 ft.,	From _____ ft. to _____ ft.		

6 GROUT MATERIALS:	1. Neat cement	2. Cement Grout	3. Bentonite	Other bentonite hole plug
Grout intervals: From 4 ft. to 24 ft.,	From _____ ft. to _____ ft.	From _____ ft. to _____ ft.	From _____ ft. to _____ ft.	
What is the nearest source of possible contamination:				
<input checked="" type="checkbox"/> 1. Septic tank <input type="checkbox"/> 4. Lateral lines <input type="checkbox"/> 7. Pit privy <input type="checkbox"/> 10. Livestock pens <input type="checkbox"/> 13. Insecticide storage <input type="checkbox"/> 15. Oil well/Gas well				
<input type="checkbox"/> 2. Sewer lines <input type="checkbox"/> 5. Cess Pool <input type="checkbox"/> 8. Sewage lagoon <input type="checkbox"/> 11. Fuel storage <input type="checkbox"/> 14. Abandon water well <input type="checkbox"/> 16. Other (specify below)				
<input checked="" type="checkbox"/> 3. Watertight sewer line <input type="checkbox"/> 6. Seepage pit <input type="checkbox"/> 9. Feed yard <input type="checkbox"/> 12. Fertilizer storage				
Direction from well? West				How many feet? 10 ft. plus

From	To	LITHOLOGIC LOG	From	To	LITHOLOGIC LOG
0	3	topsoil			
3	12	clay			
12	20	clay and very fine sand			
20	45	brown shale			
45	130	gray shale			

7 Contractor's or Landowner's Certification: This water well was 1. **constructed** 2. **reconstructed** or 3. **plugged** under my jurisdiction and was completed on (mo/day/year) **11-23-16** and this record is true to the best of my knowledge and belief.

Kansas Water Well Contractor's License No. **236** This water well record was completed on (mo/day/year) **11/25/16**

under the business name of **Harp Well and Pump Service** by (signature) *Todd S. Harp*