


1 LOCATION OF WATER WELL: Fraction SW 1/4 SE 1/4 NW 1/4 Section Number 6 Township Number 28 S Range Number 2 EW

Distance and direction from nearest town or city street address of well if located within city?
2165 So 208th West Ordway KS.

2 WATER WELL OWNER: Stawson Development
 RR#, St. Address, Box #: 10309 W. Central
 City, State, ZIP Code: Wichita KS 67412
 Board of Agriculture, Division of Water Resources
 Application Number:

3 LOCATE WELL'S LOCATION WITH AN "X" IN SECTION BOX:

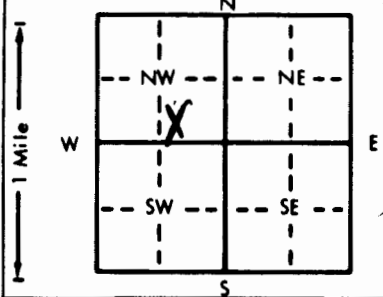

4 DEPTH OF COMPLETED WELL: 52 ft. ELEVATION:

Depth(s) Groundwater Encountered 1. 18 ft. 2. 18 ft. 3. 18 ft.
 WELL'S STATIC WATER LEVEL 18 ft. below land surface measured on mo/day/yr 1-31-86
 Pump test data: Well water was 18 ft. after 2 hours pumping 20 gpm
 Est. Yield 30 gpm: Well water was 18 ft. after 2 hours pumping 20 gpm
 Bore Hole Diameter: 11 in. to 52 ft., and 52 ft. to 52 ft.
 WELL WATER TO BE USED AS:
 1 Domestic 3 Feedlot 6 Oil field water supply 9 Dewatering 12 Other (Specify below)
 2 Irrigation 4 Industrial 7 Lawn and garden only 10 Observation well
 Was a chemical/bacteriological sample submitted to Department? Yes X No X; If yes, mo/day/yr sample was submitted
 Water Well Disinfected? Yes X No X

5 TYPE OF BLANK CASING USED:
 1 Steel 2 PVC 3 RMP (SR) 4 ABS
 5 Wrought iron 6 Asbestos-Cement 7 Fiberglass 8 Concrete tile 9 Other (specify below)
 CASING JOINTS: Glued X Clamped Welded Threaded

Blank casing diameter 5 in. to 30 ft., Dia 5 in. to 30 ft., Dia 5 in. to 30 ft.
 Casing height above land surface 12 in., weight 1.59 lbs./ft. Wall thickness or gauge No. SDR-26

TYPE OF SCREEN OR PERFORATION MATERIAL:
 1 Steel 2 Brass 3 Stainless steel 4 Galvanized steel 5 Fiberglass 6 Concrete tile 7 PVC 8 RMP (SR) 9 ABS 10 Asbestos-cement 11 Other (specify) 12 None used (open hole)

SCREEN OR PERFORATION OPENINGS ARE:
 1 Continuous slot 2 Louvered shutter 3 Mill slot 4 Key punched
 5 Gauzed wrapped 6 Wire wrapped 7 Torch cut 8 Saw cut 9 Drilled holes 10 Other (specify) 11 None (open hole)

SCREEN-PERFORATED INTERVALS: From 30 ft. to 52 ft., From 30 ft. to 52 ft., From 30 ft. to 52 ft.
 GRAVEL PACK INTERVALS: From 13 ft. to 52 ft., From 13 ft. to 52 ft., From 13 ft. to 52 ft.

6 GROUT MATERIAL: 1 Neat cement 2 Cement grout 3 Bentonite 4 Other
 Grout Intervals: From 3 ft. to 13 ft., From 3 ft. to 13 ft., From 3 ft. to 13 ft., From 3 ft. to 13 ft.

What is the nearest source of possible contamination:
 1 Septic tank 4 Lateral lines 7 Pit privy 10 Livestock pens 14 Abandoned water well
 2 Sewer lines 5 Cess pool 8 Sewage lagoon 11 Fuel storage 15 Oil well/Gas well
 3 Watertight sewer lines 6 Seepage pit 9 Feedyard 12 Fertilizer storage 16 Other (specify below)
 13 Insecticide storage
 Direction from well? NE How many feet? 80

FROM	TO	LITHOLOGIC LOG	FROM	TO	LITHOLOGIC LOG
0	2	top soil			
2	24	Clay			
24	48	fine to med sand			
48	52	Shale (red)			

7 CONTRACTOR'S OR LANDOWNER'S CERTIFICATION: This water well was (1) constructed, (2) reconstructed, or (3) plugged under my jurisdiction and was completed on (mo/day/year) 1-31-86 and this record is true to the best of my knowledge and belief. Kansas Water Well Contractor's License No. 1318 this Water Well Record was completed on (mo/day/yr) 1-31-86 under the business name of Wenger Drilling by (signature) Wenger