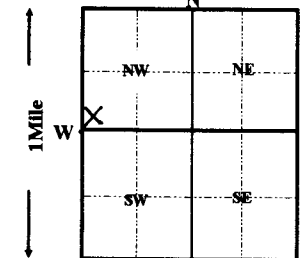


1 LOCATION OF WATER WELL: Sedgwick		FRACTION SW 1/4 SW 1/4 NW 1/4		Section Number 7	Township Number T 28 S	Range Number R 2W E/W
Distance and direction from nearest town or city street address of well if located within city? 3530 S. 215th W. Goddard, Kansas 67052						
2 WATER WELL OWNER: HOLLINGSWORTH, Earl RR#, ST. ADDRESS, BOX #: 3530 S. 215th W. CITY, STATE, ZIP CODE: Goddard, Kansas 67052 Board of Agriculture, Division of Water Resource Application Number:						
3 LOCATE WELL'S LOCATION WITH AN "X" IN SECTION BOX: 		4 DEPTH OF COMPLETED WELL 65 ft. ELEVATION: Depth(s) groundwater Encountered 1 ft. 2 ft. 3 ft. WELL'S STATIC WATER LEVEL 11 FT. BELOW LAND SURFACE MEASURED ON 01/13/1994 Pump test data: Well water was ft. after hours pumping gpm Est. Yield gpm : Well water was ft. after hours pumping gpm Bore Hole Diameter 12 in. to 65 ft. and in. to ft. WELL WATER TO BE USED AS: 1 Domestic 3 Feedlot 6 Oil field water supply 9 Dewatering 12 Other (Specify below) 2 Irrigation 4 Industrial 7 Lawn and garden only 10 Monitoring well Was a chemical/bacteriological sample submitted to Department? Yes No X ; If yes, mo/day/yr sample was submitted Water Well Disinfected? Yes X No				
5 TYPE OF CASING USED: 1 Steel 3 RMP (SR) 5 Wrought iron 8 Concrete tile CASING JOINTS: Glued X Clamped 2 PVC 4 ABS 6 Asbestos-Cement 9 Other (Specify below) Welded 7 Fiberglass SDR-26 Threaded Blank casing Diameter 5 in. to 25 ft., Dia in. to ft. , Dia in. to ft. Casing height above land surface 12 in., weight 2.35 lbs. / ft. Wall thickness or gauge No. .214 TYPE OF SCREEN OR PERFORATION MATERIAL: 1 Steel 3 Stainless Steel 5 Fiberglass 8 RMP (SR) 10 Asbestos-cement 2 Brass 4 Galvanized steel 6 Concrete tile 9 ABS 11 other (specify) 12 None used (open hole) SCREEN OR PERFORATION OPENING ARE: 1 Continuous slot 3 Mill slot 5 Gauzed wrapped 8 Saw cut 11 None (open hole) 2 Louvered shutter 4 Key punched 6 Wire wrapped 9 Drilled holes 7 Torch cut 10 Other (specify) SCREEN-PERFORATION INTERVALS: from 24 ft. to 65 ft., From ft. to ft. GRAVEL PACK INTERVALS: from 24 ft. to 65 ft., From ft. to ft. from ft. to ft.						
6 GROUT MATERIAL: 1 Neat cement 2 Cement grout 3 Bentonite 4 Other Grout Intervals: From 4 ft. to 24 ft. From ft. to ft. What is the nearest source of possible contamination: 1 Septic tank 4 Lateral lines 7 Pit privy 10 Livestock pens 14 Abandon water well 2 Sewer lines 5 Cess pool 8 Sewage lagoon 11 Fuel storage 15 Oil well/Gas well 3 Watertight sewer lines 6 Seepage pit 9 Feedyard 12 Fertilizer storage 16 Other (specify below) None Apparent Direction from well? How many feet?						
FROM	TO	LITHOLOGIC LOG	FROM	TO	PLUGGING INTERVALS	
0	3	topsoil				
3	13	clay			SEPTIC SYSTEM NOT INSTALLED	
13	32	fine sand			AT THIS TIME	
32	65	grey shale				
7 CONTRACTOR'S OR LANDOWNER'S CERTIFICATION: This water well was (1) constructed, (2) reconstructed, or (3) plugged under my jurisdiction and was completed on (mo/day/year) 01/13/1994 and this record is true to the best of my knowledge and belief. Kansas Water Well Contractor's License No. 236 This Water Well Record was completed on (mo/day/yr) 01/17/94 Under the business name of Harp Well & Pump by (signature) Jane Frederick						